

AMENDMENT OF SOLICITATION/MODIFICATION OF CONTRACT	1. CONTRACT ID CODE	PAGE OF PAGES
---	---------------------	---------------

2. AMENDMENT/MODIFICATION NO.	3. EFFECTIVE DATE	4. REQUISITION/PURCHASE REQ. NO.	5. PROJECT NO. (If applicable)
-------------------------------	-------------------	----------------------------------	--------------------------------

6. ISSUED BY	CODE	7. ADMINISTERED BY (If other than Item 6)	CODE
--------------	------	---	------

8. NAME AND ADDRESS OF CONTRACTOR (No., street, county, State and ZIP Code)	(X)	9A. AMENDMENT OF SOLICITATION NO.
		9B. DATED (SEE ITEM 11)
		10A. MODIFICATION OF CONTRACT/ORDER NO.
		10B. DATED (SEE ITEM 11)
CODE		FACILITY CODE

11. THIS ITEM ONLY APPLIES TO AMENDMENTS OF SOLICITATIONS

The above numbered solicitation is amended as set forth in Item 14. The hour and date specified for receipt of Offers is extended, is not extended. Offers must acknowledge receipt of this amendment prior to the hour and date specified in the solicitation or as amended, by one of the following methods:

(a) By completing items 8 and 15, and returning _____ copies of the amendment; (b) By acknowledging receipt of this amendment on each copy of the offer submitted; or (c) By separate letter or telegram which includes a reference to the solicitation and amendment numbers. FAILURE OF YOUR ACKNOWLEDGMENT TO BE RECEIVED AT THE PLACE DESIGNATED FOR THE RECEIPT OF OFFERS PRIOR TO THE HOUR AND DATE SPECIFIED MAY RESULT IN REJECTION OF YOUR OFFER. If by virtue of this amendment your desire to change an offer already submitted, such change may be made by telegram or letter, provided each telegram or letter makes reference to the solicitation and this amendment, and is received prior to the opening hour and date specified.

12. ACCOUNTING AND APPROPRIATION DATA (If required)

13. THIS ITEM ONLY APPLIES TO MODIFICATION OF CONTRACTS/ORDERS. IT MODIFIES THE CONTRACT/ORDER NO. AS DESCRIBED IN ITEM 14.

CHECK ONE	A. THIS CHANGE ORDER IS ISSUED PURSUANT TO: (Specify authority) THE CHANGES SET FORTH IN ITEM 14 ARE MADE IN THE CONTRACT ORDER NO. IN ITEM 10A.
	B. THE ABOVE NUMBERED CONTRACT/ORDER IS MODIFIED TO REFLECT THE ADMINISTRATIVE CHANGES (such as changes in paying office, appropriation date, etc.) SET FORTH IN ITEM 14, PURSUANT TO THE AUTHORITY OF FAR 43.103(b).
	C. THIS SUPPLEMENTAL AGREEMENT IS ENTERED INTO PURSUANT TO AUTHORITY OF:
	D. OTHER (Specify type of modification and authority)

E. IMPORTANT: Contractor is not, is required to sign this document and return _____ copies to the issuing office.

14. DESCRIPTION OF AMENDMENT/MODIFICATION (Organized by UCF section headings, including solicitation/contract subject matter where feasible.)

Except as provided herein, all terms and conditions of the document referenced in Item 9A or 10A, as heretofore changed, remains unchanged and in full force and effect.

15A. NAME AND TITLE OF SIGNER (Type or print)	16A. NAME AND TITLE OF CONTRACTING OFFICER (Type or print)
15B. CONTRACTOR/OFFEROR	16B. UNITED STATES OF AMERICA
15C. DATE SIGNED	16C. DATE SIGNED
(Signature of person authorized to sign)	(Signature of Contracting Officer)

- 1) The previous amendment dated 03 August 2011 was incorrectly numbered, please **DELETE** Amendment 0003 from block 2 of the previous amendment and **REPLACE** with Amendment 0002.
- 2) Question: Sheet P-1 reads as follows: "REPLACE ALL HOSE REELS. REPLACE ANY LUBE, OIL, AND AIR PIPING AS NECESSARY FOR INSTALLATION OF NEW HOSE REELS." There is no detail showing how the hose reels are installed. Please provide information/detail as to how these reels are installed and indicate to what extent any lube, oil, and air piping will need to be replaced.

Answer: Remove the existing reel and replace with a new unit, reusing the same support and pipe supply. New piping shall consist of reworking the piping adjacent to the reel to install the new unit. Bulletin drawing PBD1 is attached to clarify the requirements (Page 3).

- 3) Question: Sheet P-2 gives us a specification for the hose reels, and appears to give a detail of how piping is attached to oil, grease, and transmission drums. What is the intent for this detail? We are not told to do anything with it, such as "provide new," or "connect to existing." Where it is located on the drawings, etc. Please advise.

Answer: Remove the existing lube pump and modify the piping adjacent to the drums. See bulletin drawings PBD2 and PBD3 for clarification (Pages 4 and 5).

- 4) Question: Sheet P-2 indicates in the hose reel specification that there is a combination "Air and Water" hose reel. Are we to assume that the hose reels located on columns 6 & 15 are for this application? There appears to be another line extending off of these reels that is not labeled (water?). If this is so, are the single hose reels for air only? Please advise.

Answer: The hose reels along column line 6 and 15 are air/water units. The pipe in question is the existing water line serving the existing reel. The single hose reels are air only.

- 5) Question: Sheet D-3, Note #5 reads: "PREPARE ALL EXISTING STUCCO FOR NEW COLOR COAT, MATCH EXISTING COLOR. REPAIR EXISTING DAMAGE TO STUCCO (APPROXIMATELY 24 SF)."

Sheet A-5, Note #2 reads: "CONTRACTOR TO INSTALL NEW COLOR COAT OF STUCCO TO MATCH EXISTING, TYPICAL."

These notes can be interpreted two different ways. For clarification, are we to patch the 24 SF area and paint the stucco to match existing color? Or are we to apply an entirely new color coat of stucco to match the existing stucco color. Please advise

Answer: Contractor shall repair existing damage to stucco finish (24 square feet for bid purposes). Contractor shall also apply a new color coat to all existing stucco, including repaired area. Contractor is to match existing color.

EXISTING HOSE REELS TO BE REPLACED WITH NEW. PROVIDE NEW PIPING AS NEEDED TO INSTALL UNIT; MOUNT REEL TO EXIST. SUPPORT BEAM



DEPARTMENT OF THE NAVY NAVAL FACILITIES ENGINEERING COMMAND
MARINE CORPS BASE
CAMP LEJEUNE, NORTH CAROLINA



FLUID DRUM & HOSE
 REEL DETAILS

Interior and Exterior Repairs
 to HP 100

SCALE
 NOTED

DATE
 8-1-11

DESIGN BY
 JCC

NAVFAC DWG #
 600008323

DRAWING NO.

PBD1

PROVIDE PUMP & PIPING TO CONNECT TO EXISTING DRUMS. REFER TO DETAIL 1/P2 & PBD3

PROVIDE NEW PIPING TO POINT OF CONNECTION TO EXISTING PIPING



DEPARTMENT OF THE NAVY NAVAL FACILITIES ENGINEERING COMMAND
MARINE CORPS BASE
CAMP LEJEUNE, NORTH CAROLINA

WALKER
the **GROUP**
ARCHITECTURE

FLUID DRUM & HOSE
REEL DETAILS

Interior and Exterior Repairs
to HP 100

SCALE
NOTED


DATE
8-1-11

DESIGN BY
JCC

NAVFAC DWG #
600008323

DRAWING NO.

PBD2

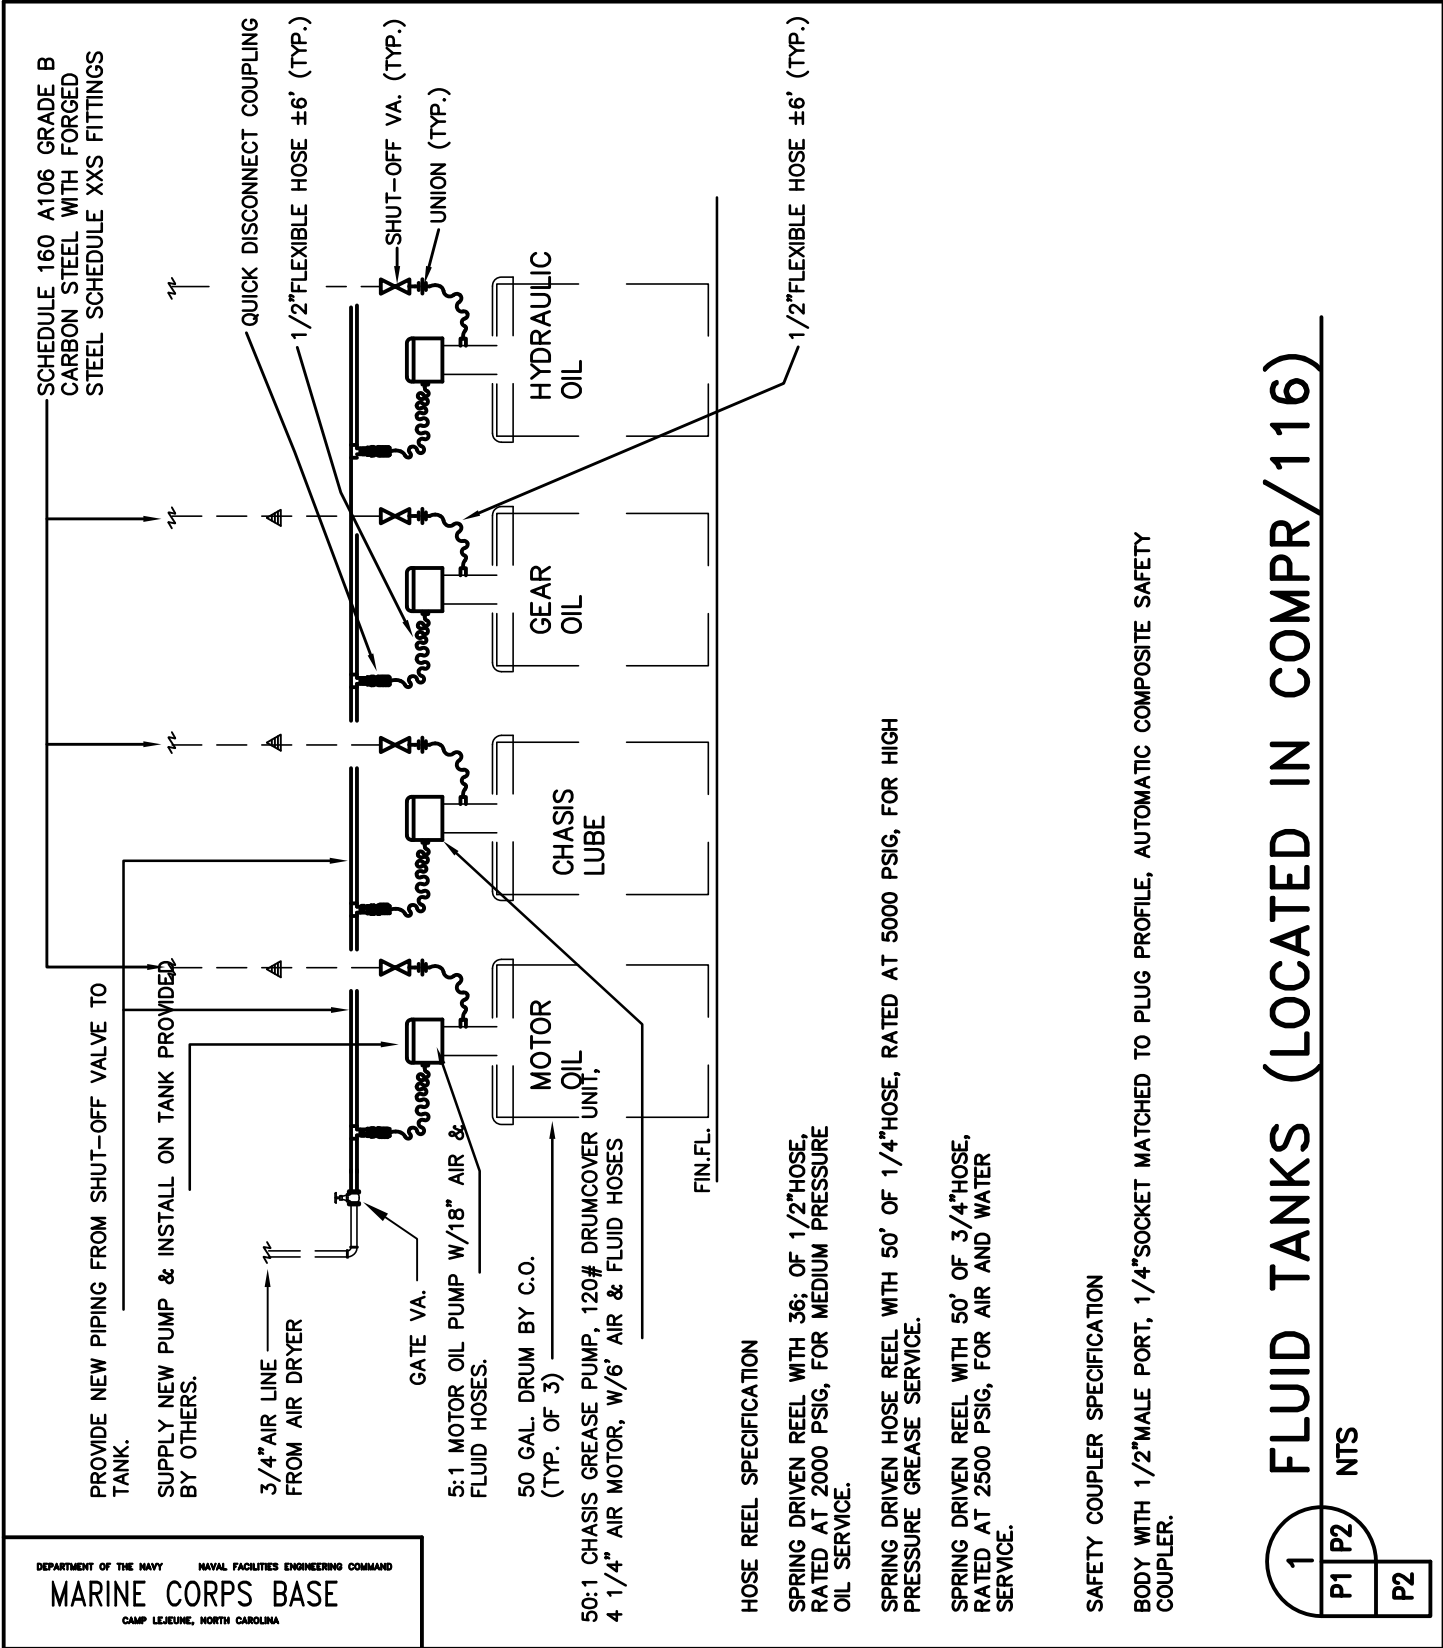

FLUID TANKS (LOCATED IN COMPR/116)

1	P2
P1	P2

NTS



FLUID DRUM & HOSE REEL DETAILS

Interior and Exterior Repairs to HP 100

SCALE NOTED

DATE 8-1-11

DESIGN BY JCC

NAVFAC DWG # 600008323

DRAWING NO.

PBD3