


GENERAL NOTES:

1. VERIFY MECH. CHASE WALL ENCLOSURE DIMENSIONS WITH MECHANICAL DRAWINGS.
2. FOR SPECIAL FRAME (SF-1) ELEVATIONS, SEE SHEET A-25.
3. SEE STRUCTURAL DRAWINGS FOR SHEAR WALL LOCATIONS AND CONNECTIONS.

DATE:	05/16/94
PROJECT#:	9305
DESIGNED BY:	W.G.F.
DRAWN BY:	C.J.S.
CHECKED BY:	T.W.L.
CHECKED BY:	

SHEET NO.:

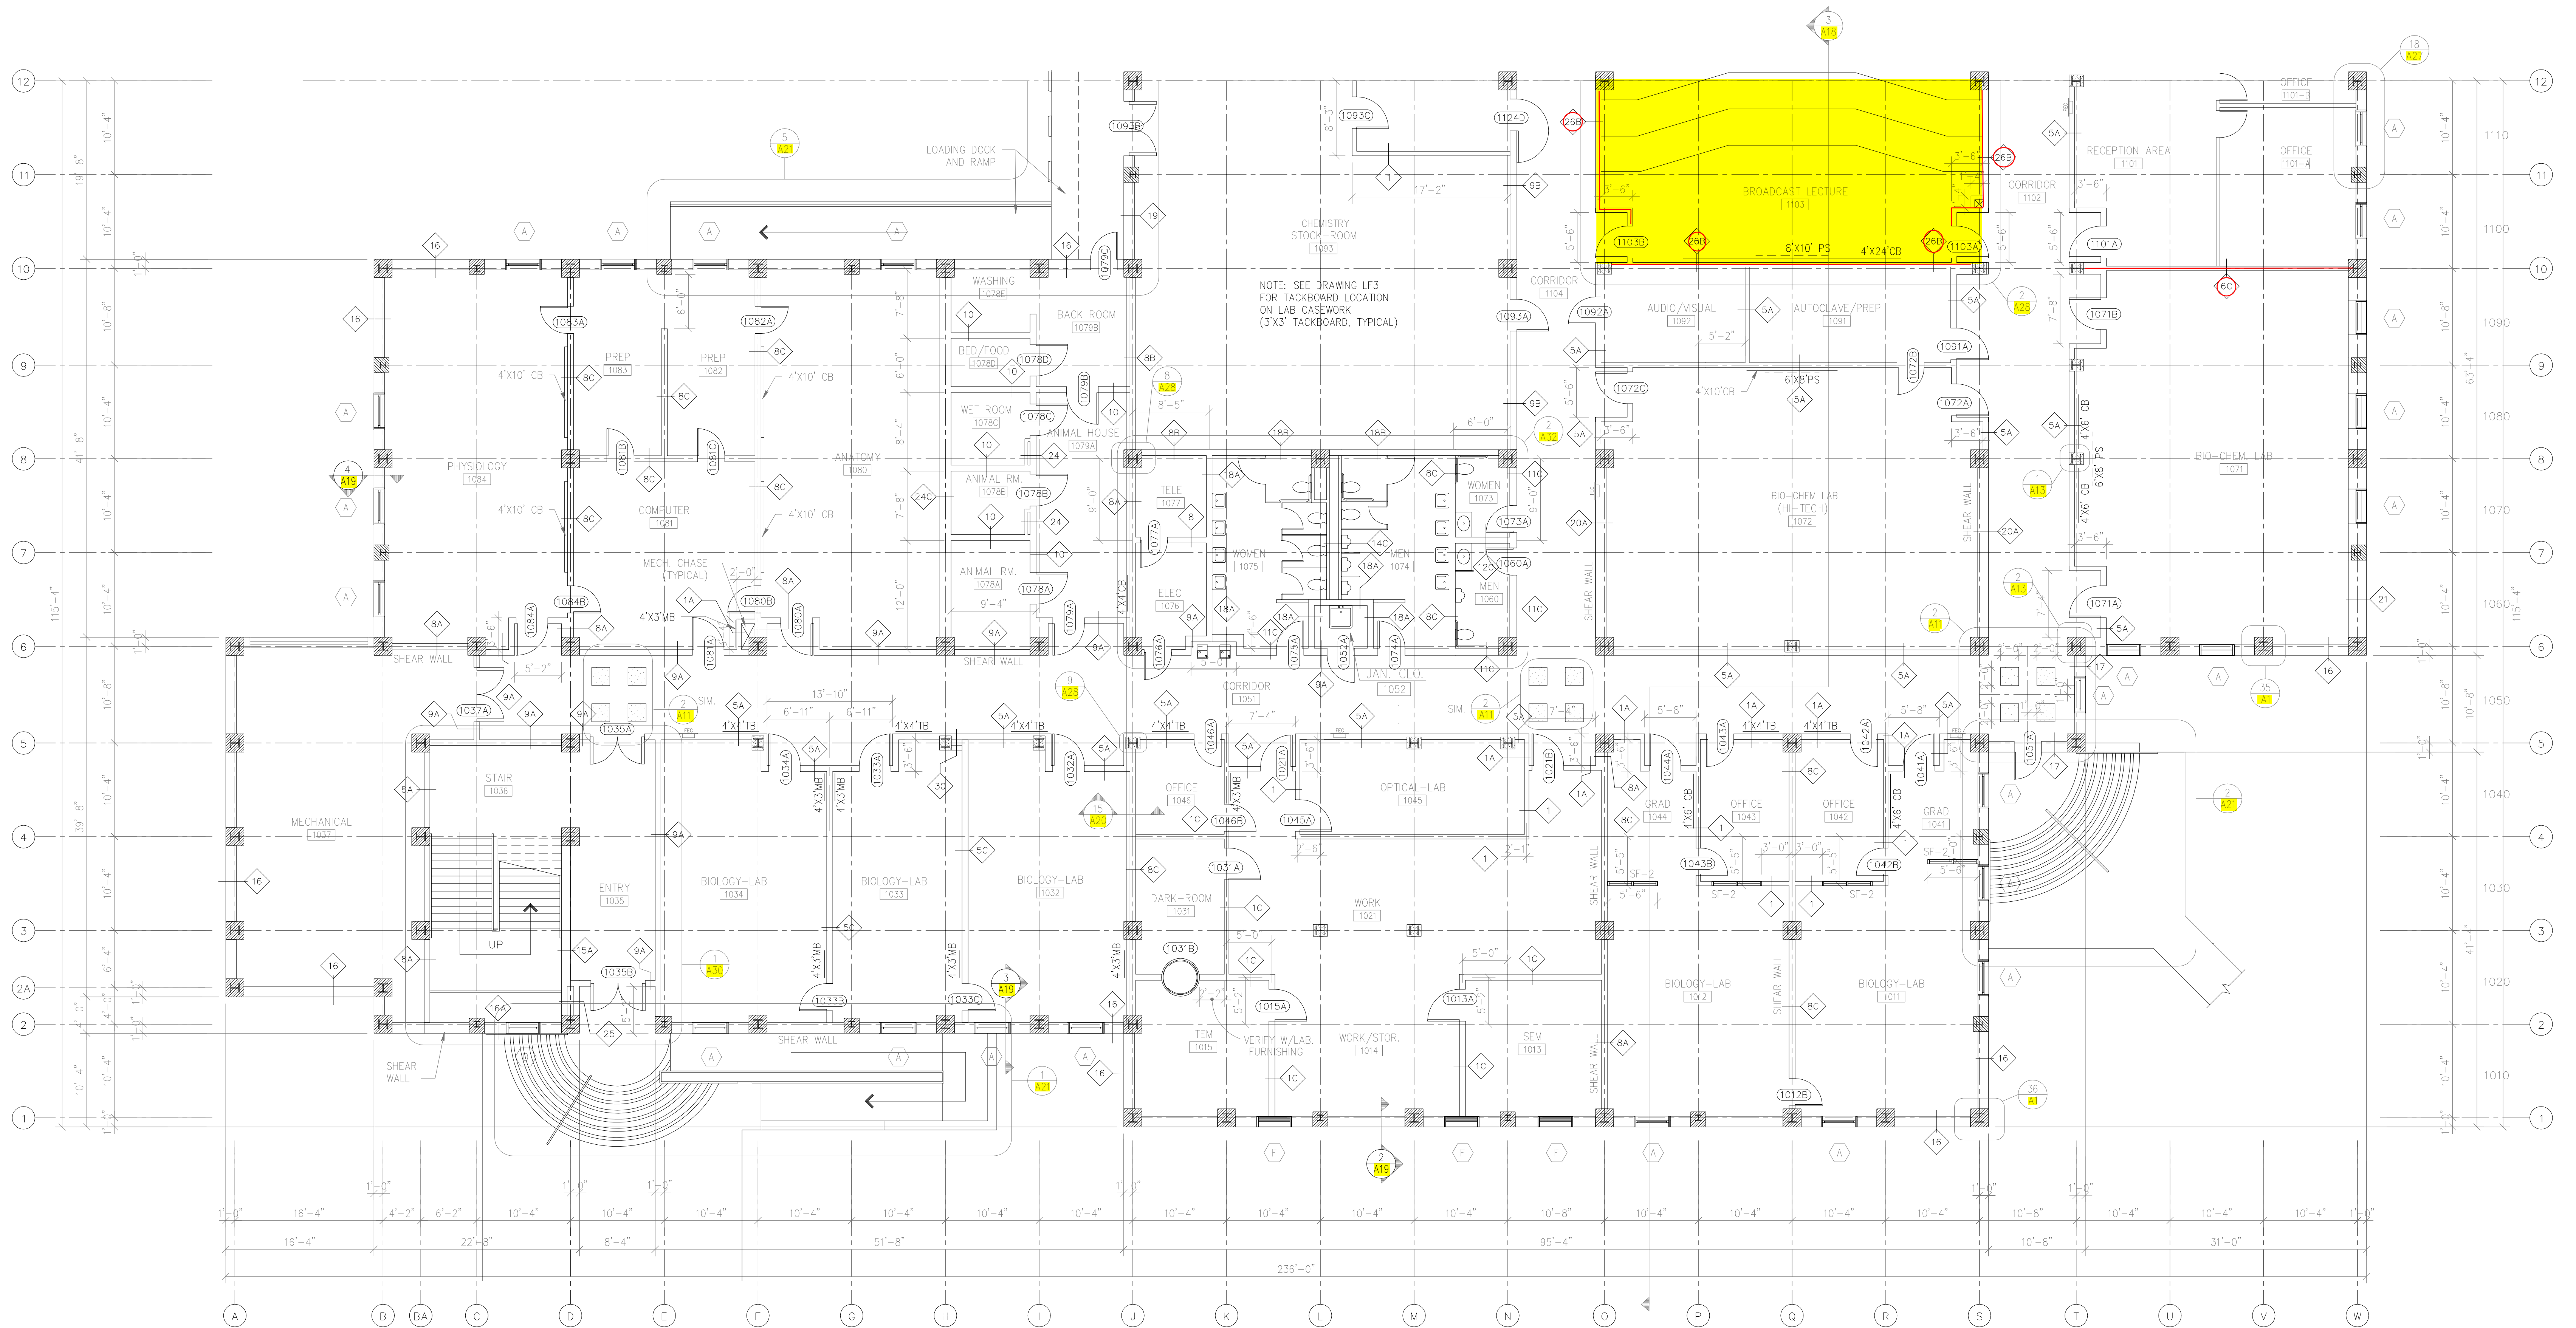

E:\9305\A4 122795 ASBUILT - MAG