


**JEFFERIES AND FARIS ASSOCIATES**  
ARCHITECTS • PLANNERS  
SEA TOWERS, SUITE 201  
2002 EASTWOOD ROAD  
WILMINGTON, N.C. 28403  
TEL: 910.256.6633  
FAX: 910.256.9088



SCIENCE BUILDING  
UNIVERSITY OF NORTH CAROLINA AT WILMINGTON  
CODE 44388 ITEM 301 ID#60842B0301A

# SERVICE FITTING SCHEDULE

EXAMPLE: FITTINGS MAY ALSO BE INDICATED INDIVIDUALLY ON FLOOR PLANS.  
G-1A INDICATES TYPE OF FITTING ABBREVIATED INDIVIDUALLY ON FLOOR PLANS.  
LA-1C NUMERICAL REFERENCE OF FITTING ELEV. A = 7" IF B = 21" OR LESS  
SEE DRAWING LF-16. A = 9" IF B > 21"

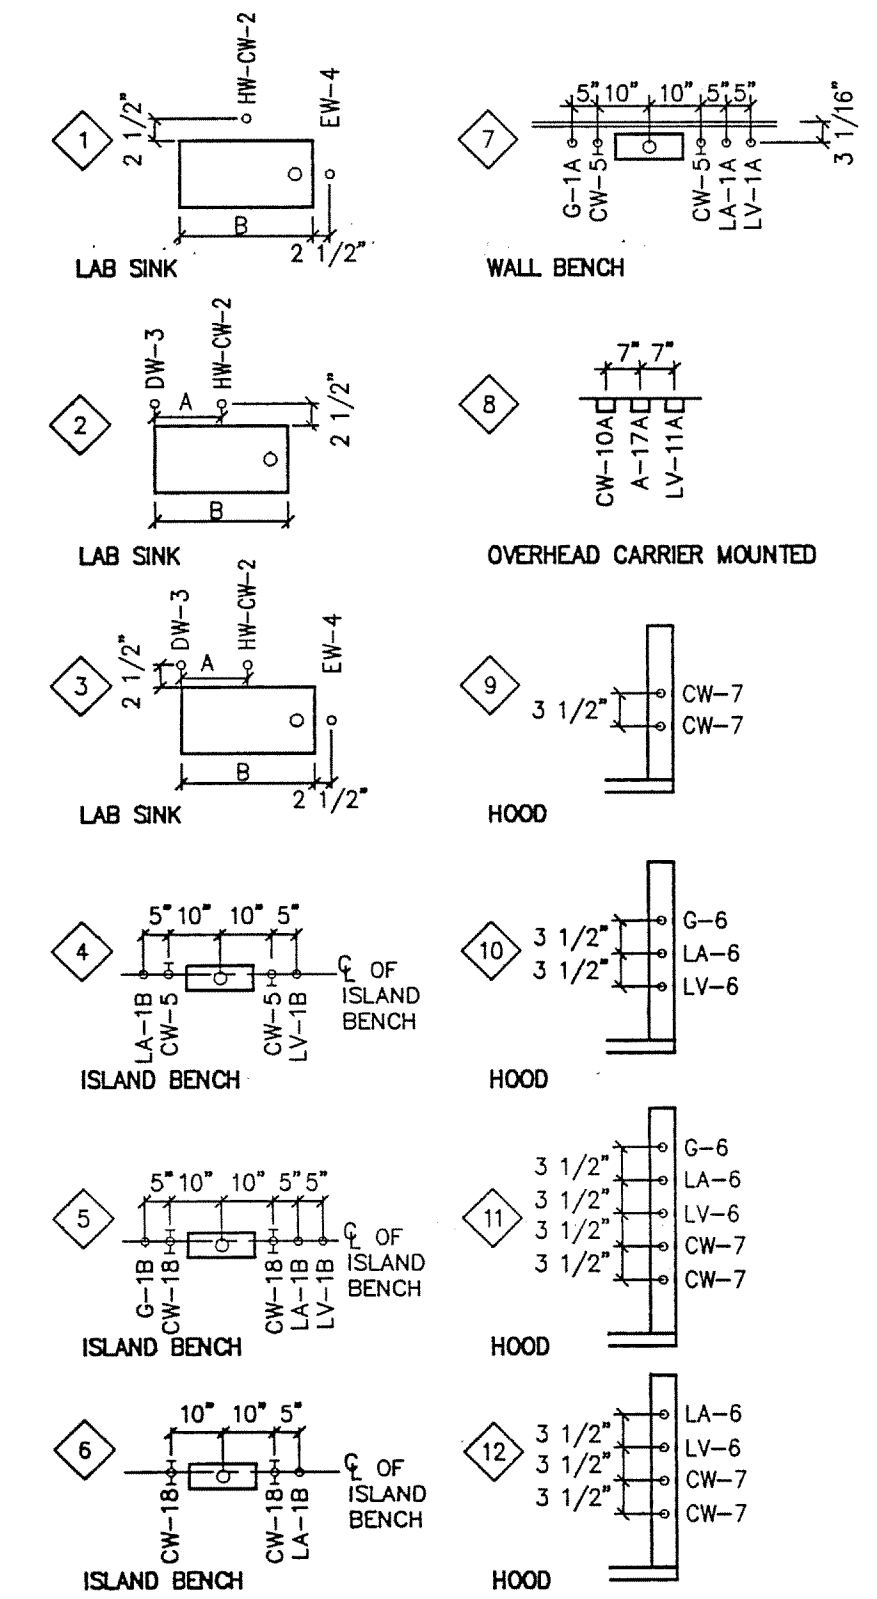

SECOND FLOOR  
SCALE: 1/4" = 1'-0"

AREA FIVE  
AS BUILT

DRAWING REVISIONS:		
NO.	DATE	REMARKS

DATE: 5/16/94  
PROJECT#: 8962  
DESIGNED BY: PJK  
DRAWN BY: LKH  
CHECKED BY: PJK

SHEET NO.:

**LF10**

**Wall**  
Earl Wall Associates  
Laboratory Design Consultants  
5348 Carroll Canyon Road  
San Diego, California 92121  
(619)457-2400