


SCIENCE BUILDING  
UNIVERSITY OF NORTH CAROLINA AT WILMINGTON  
CODE 44300 ITEM 301 ID#6089280801A


SHEET TITLE:

LAB FURNISHINGS  
DETAILS

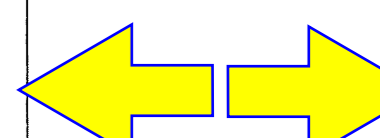


SHEET NO.:



LF13

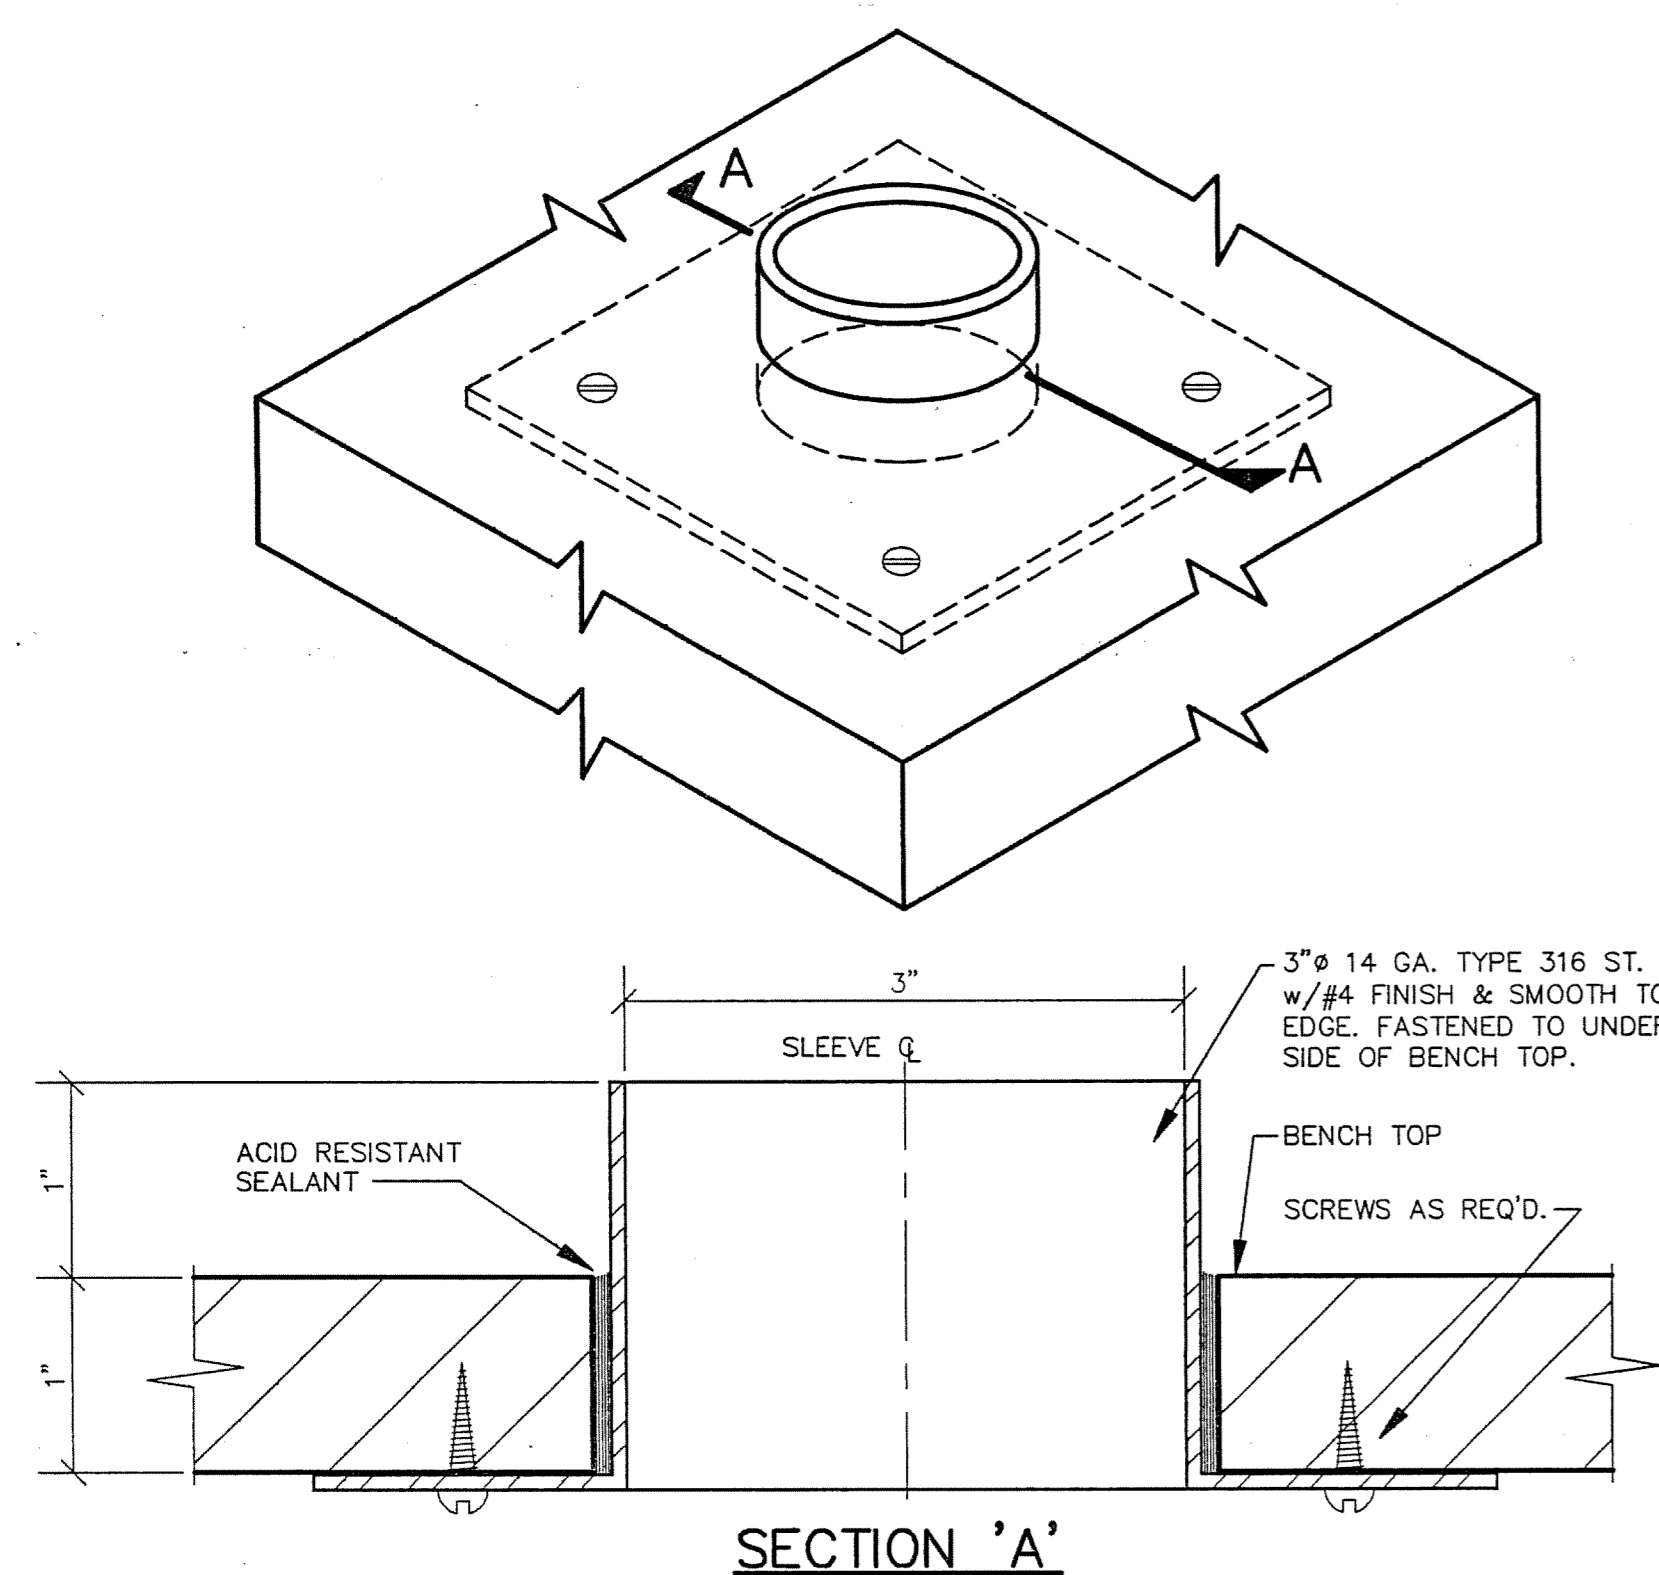

SECTION 'A'

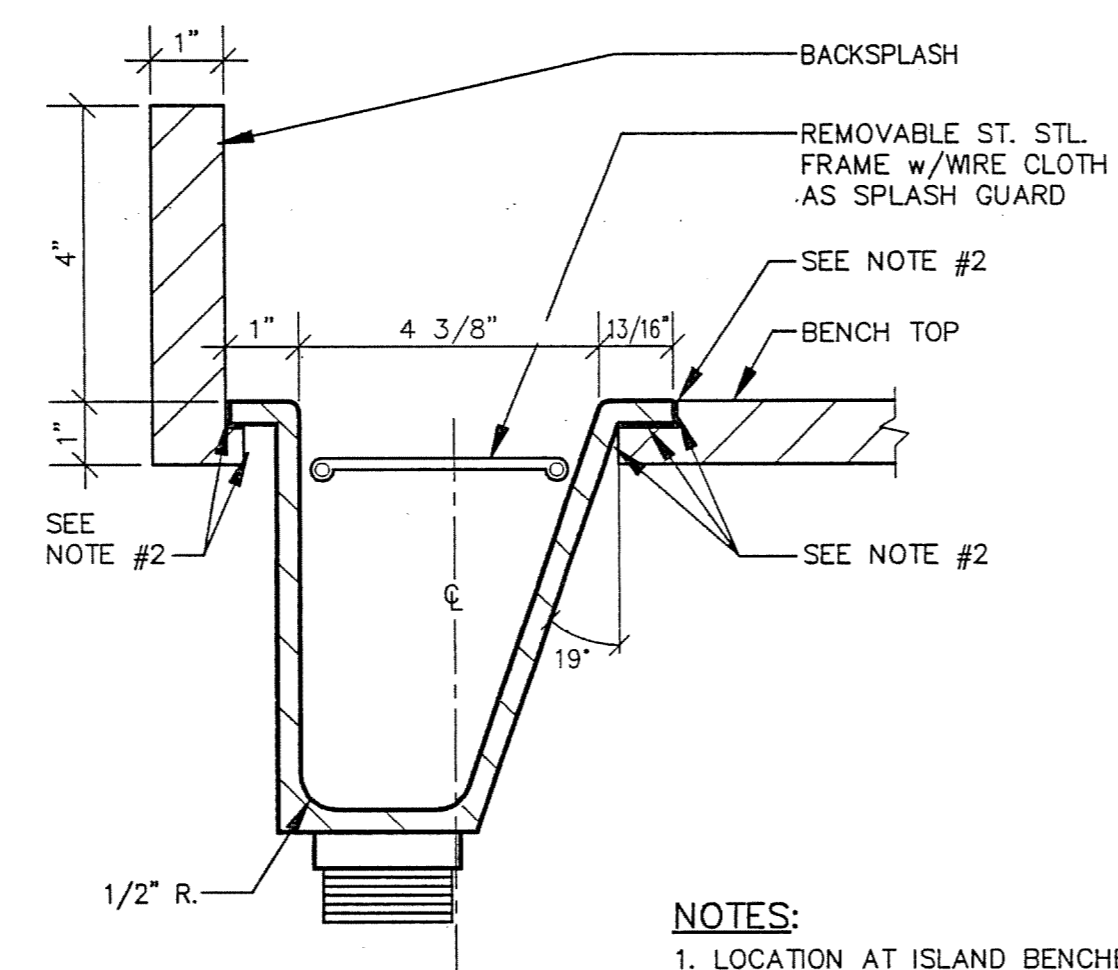

- NOTES:
1. LOCATION AT ISLAND BENCHES TO BE  $\frac{1}{2}$  OF BENCH.
  2. PROVIDE A WATER TIGHT SEAL AT ALL ACID RESISTANT PLASTIC LAMINATE TOP CUT EDGES.

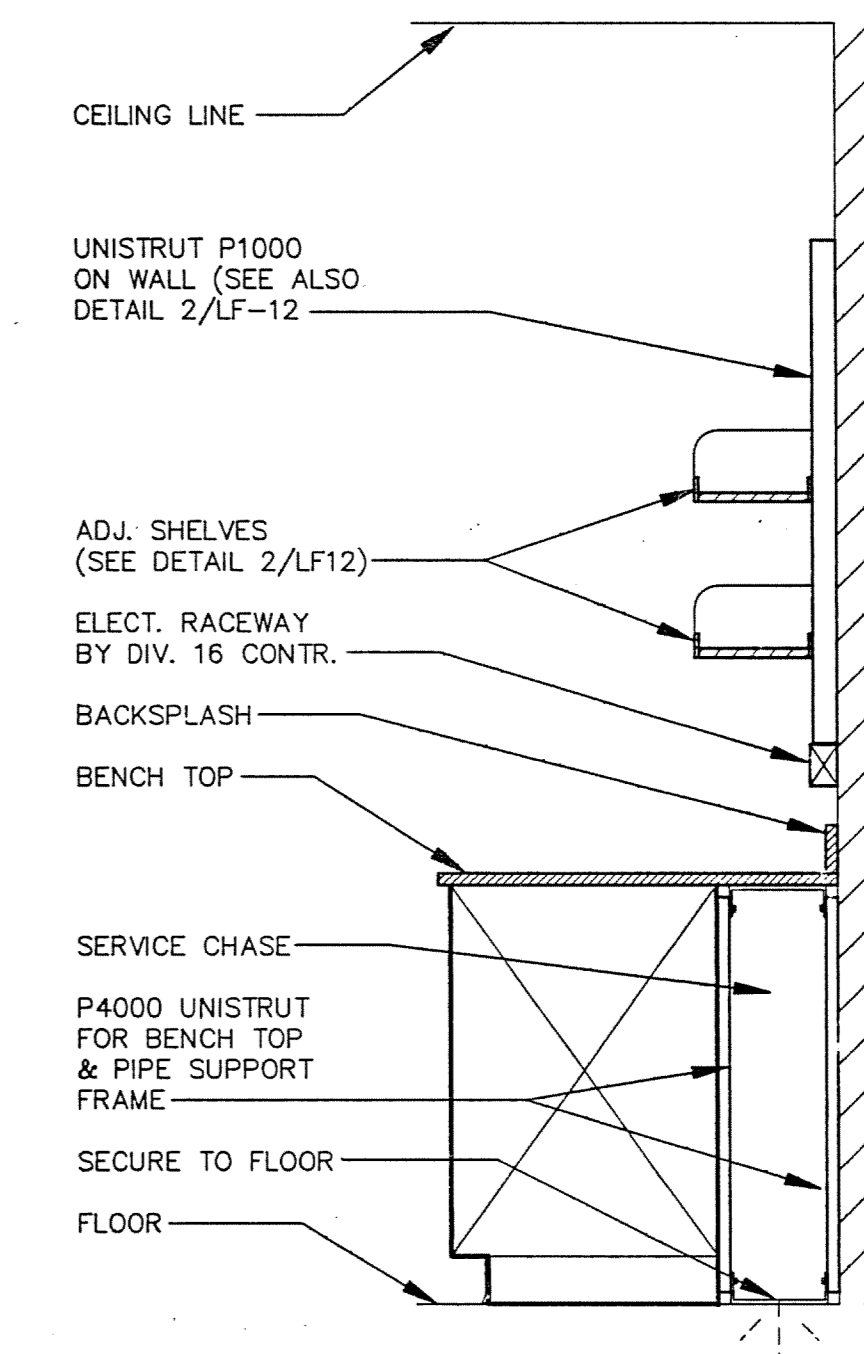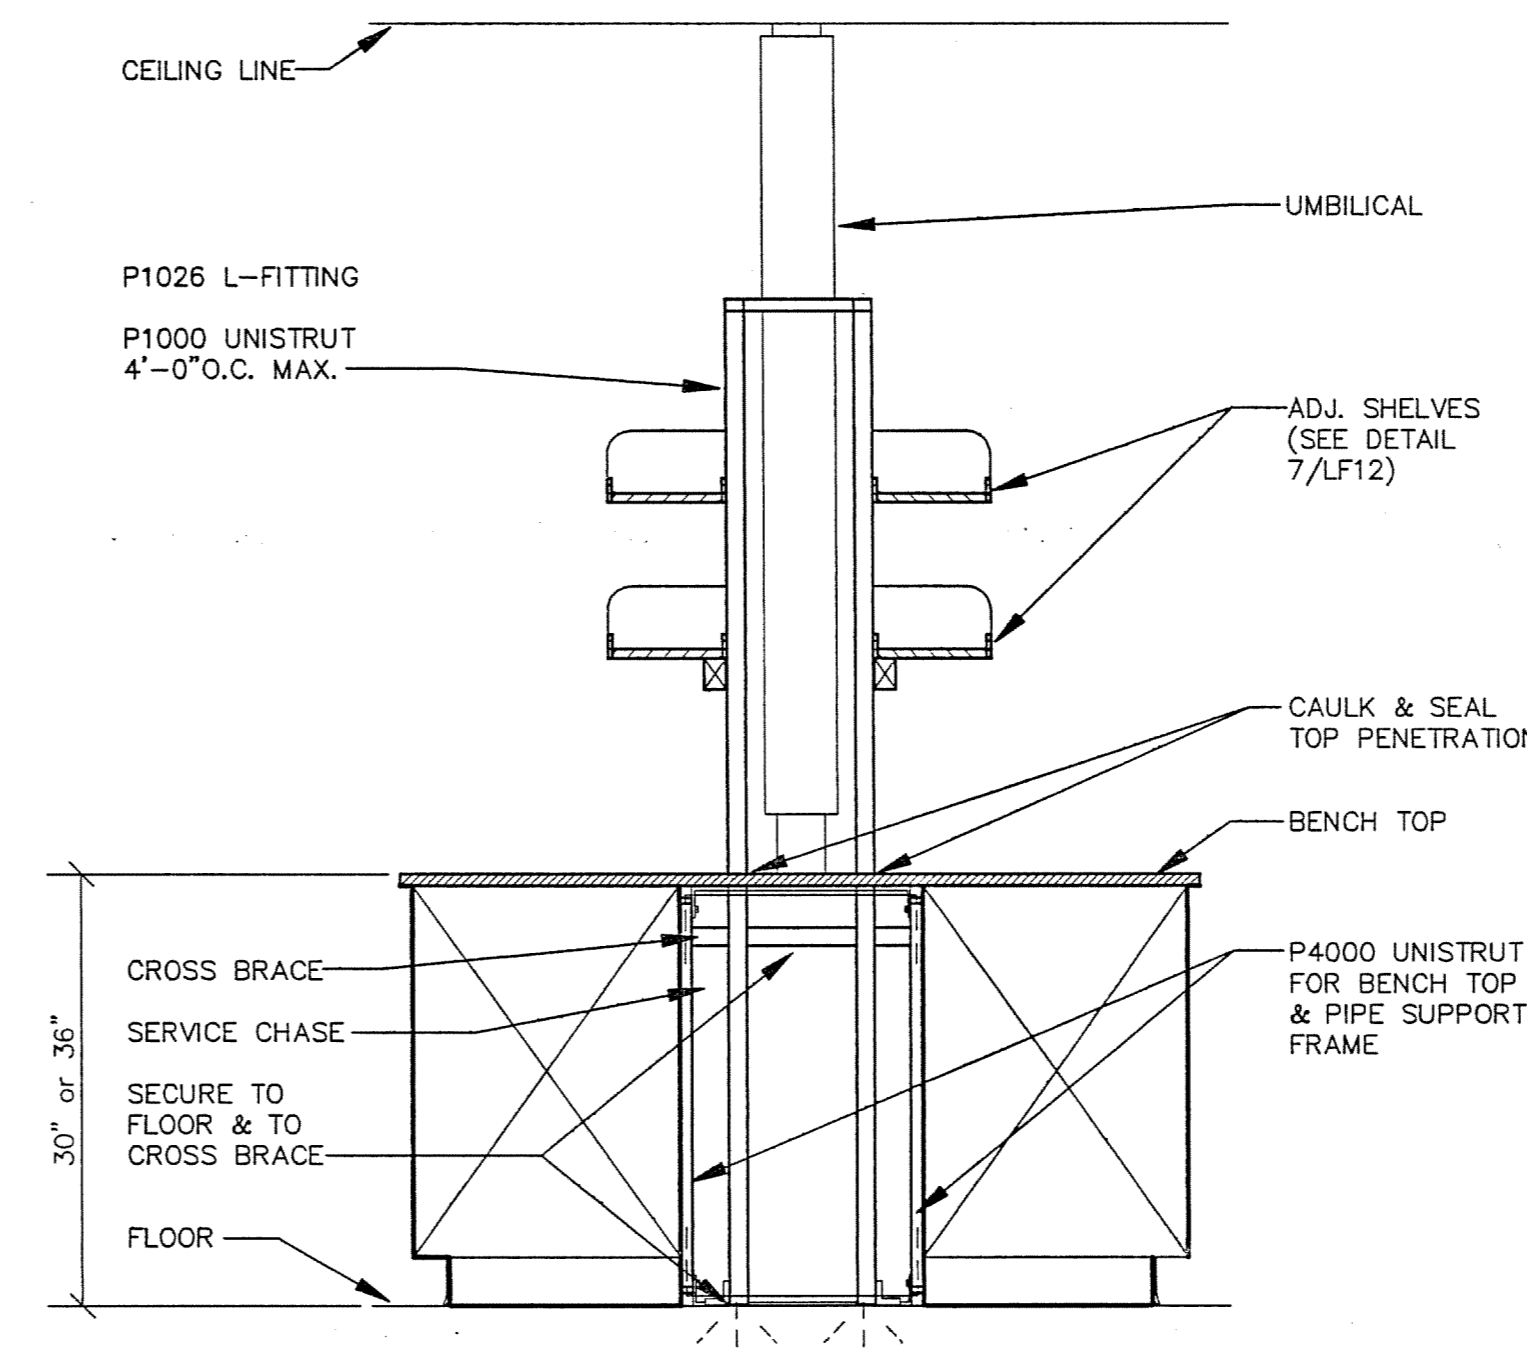

# 1 BENCH TOP SLEEVE

SCALE: 1/2" = 1'-0"

EARL WALLS ASSOCIATES © 1994

# 2 TYPICAL CUPSINK DETAIL

NOT TO SCALE

EARL WALLS ASSOCIATES © 1994

# 3 TYPICAL ISLAND BENCH DETAIL


SCALE: 3/4" = 1'-0"

EARL WALLS ASSOCIATES © 1994

# 4 TYPICAL WALL BENCH DETAIL


SCALE: 3/4" = 1'-0"

EARL WALLS ASSOCIATES © 1994

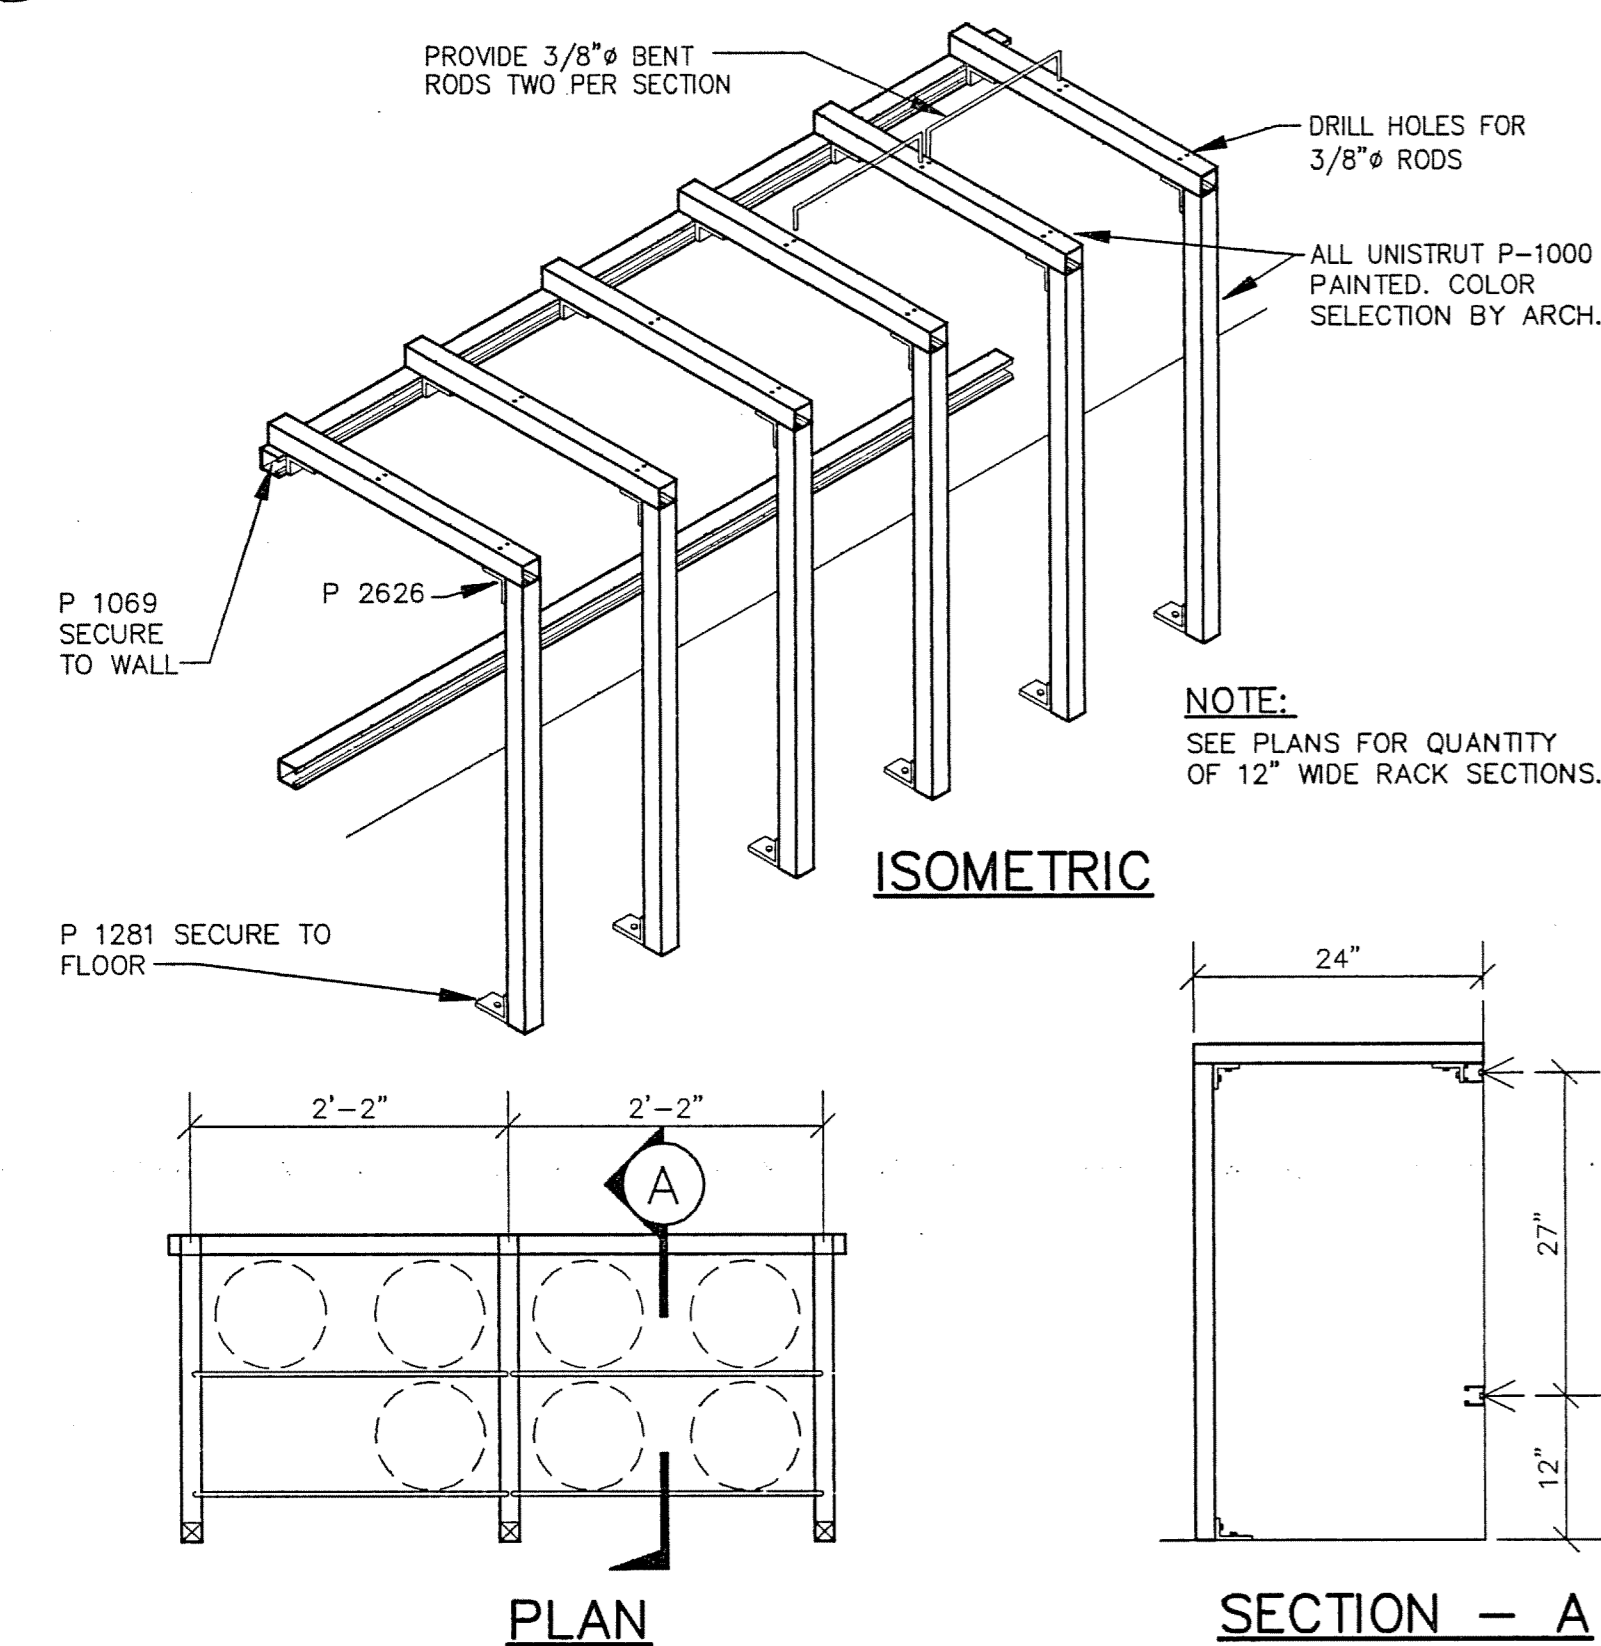


ISOMETRIC

NOTE:  
SEE PLANS FOR QUANTITY OF 12" WIDE RACK SECTIONS.

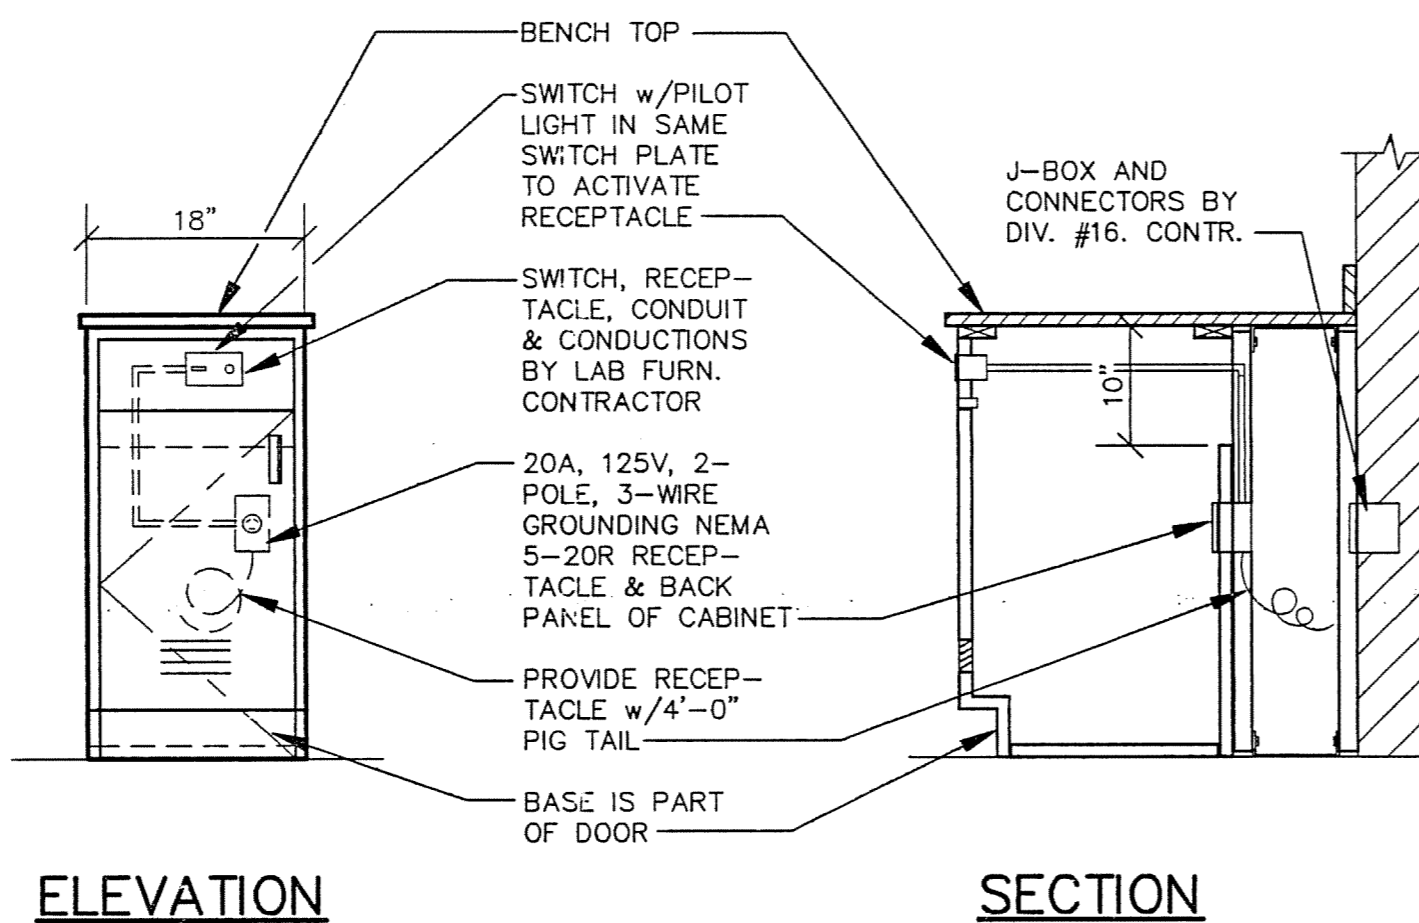


ELEVATION

SECTION

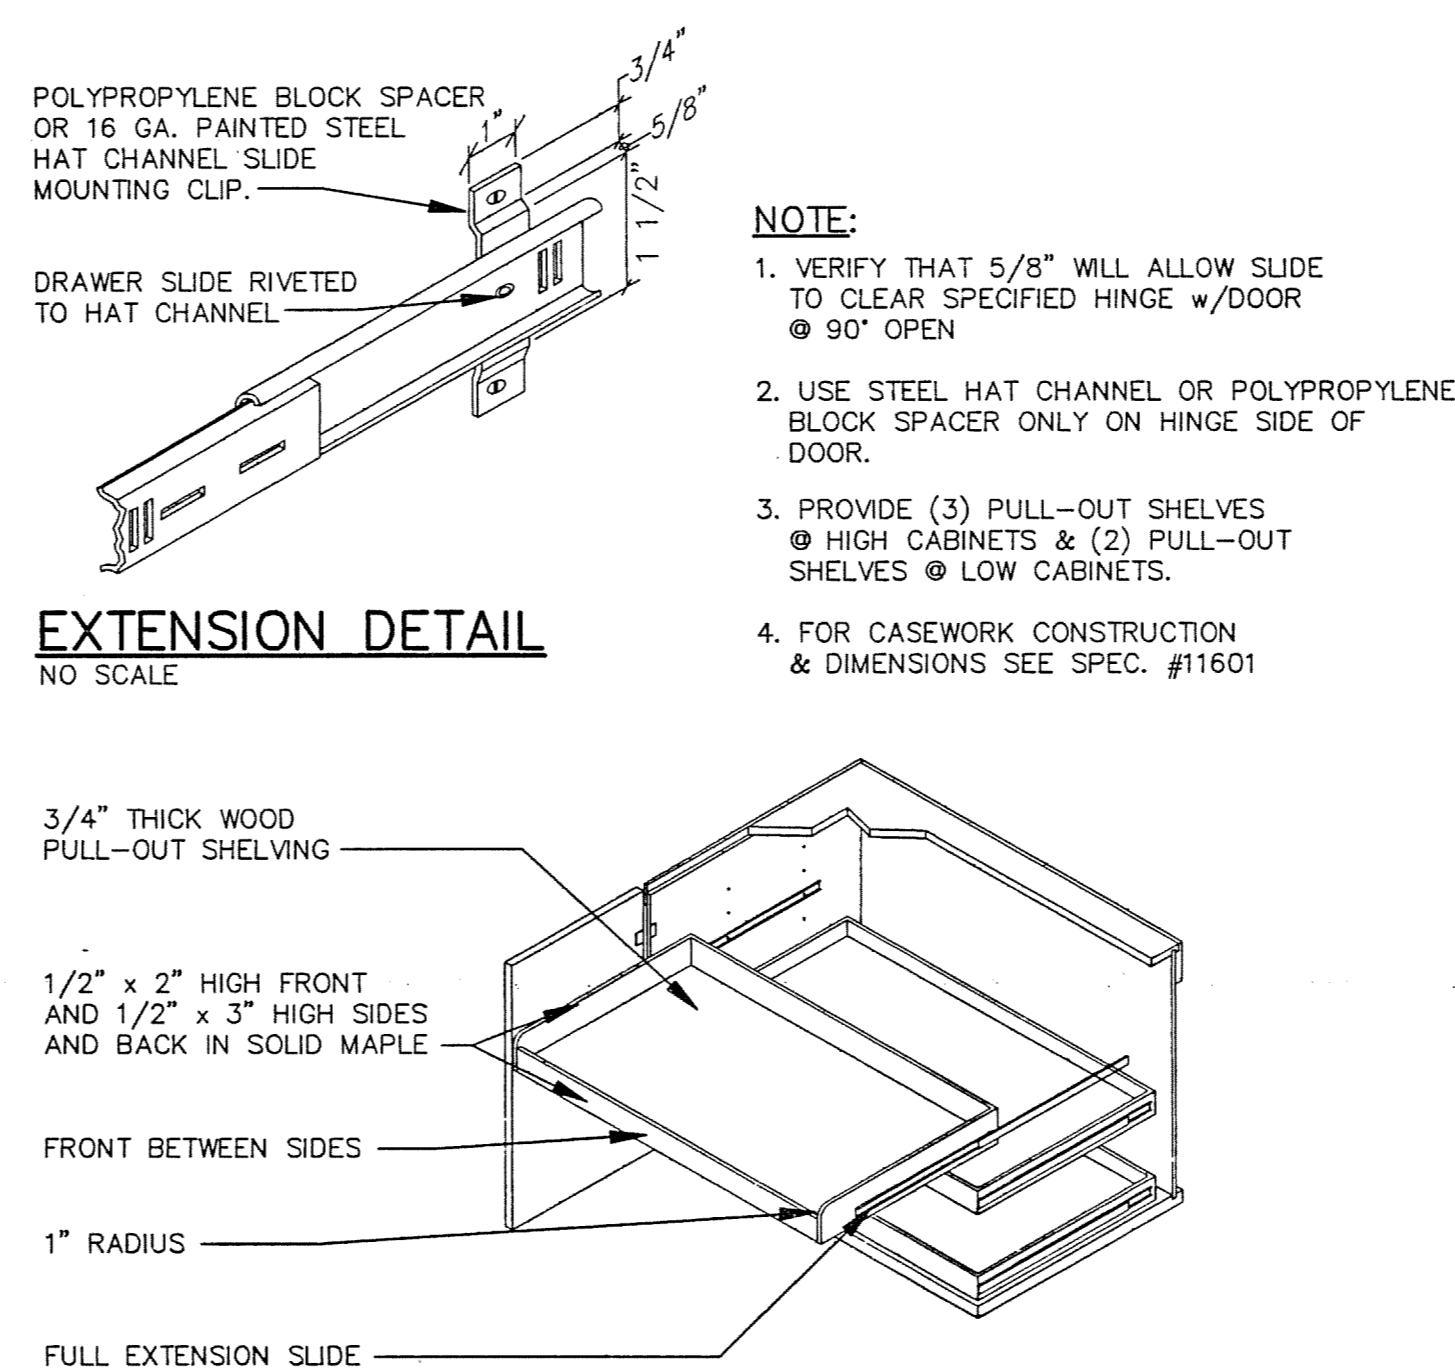

EXTENSION DETAIL

NO SCALE

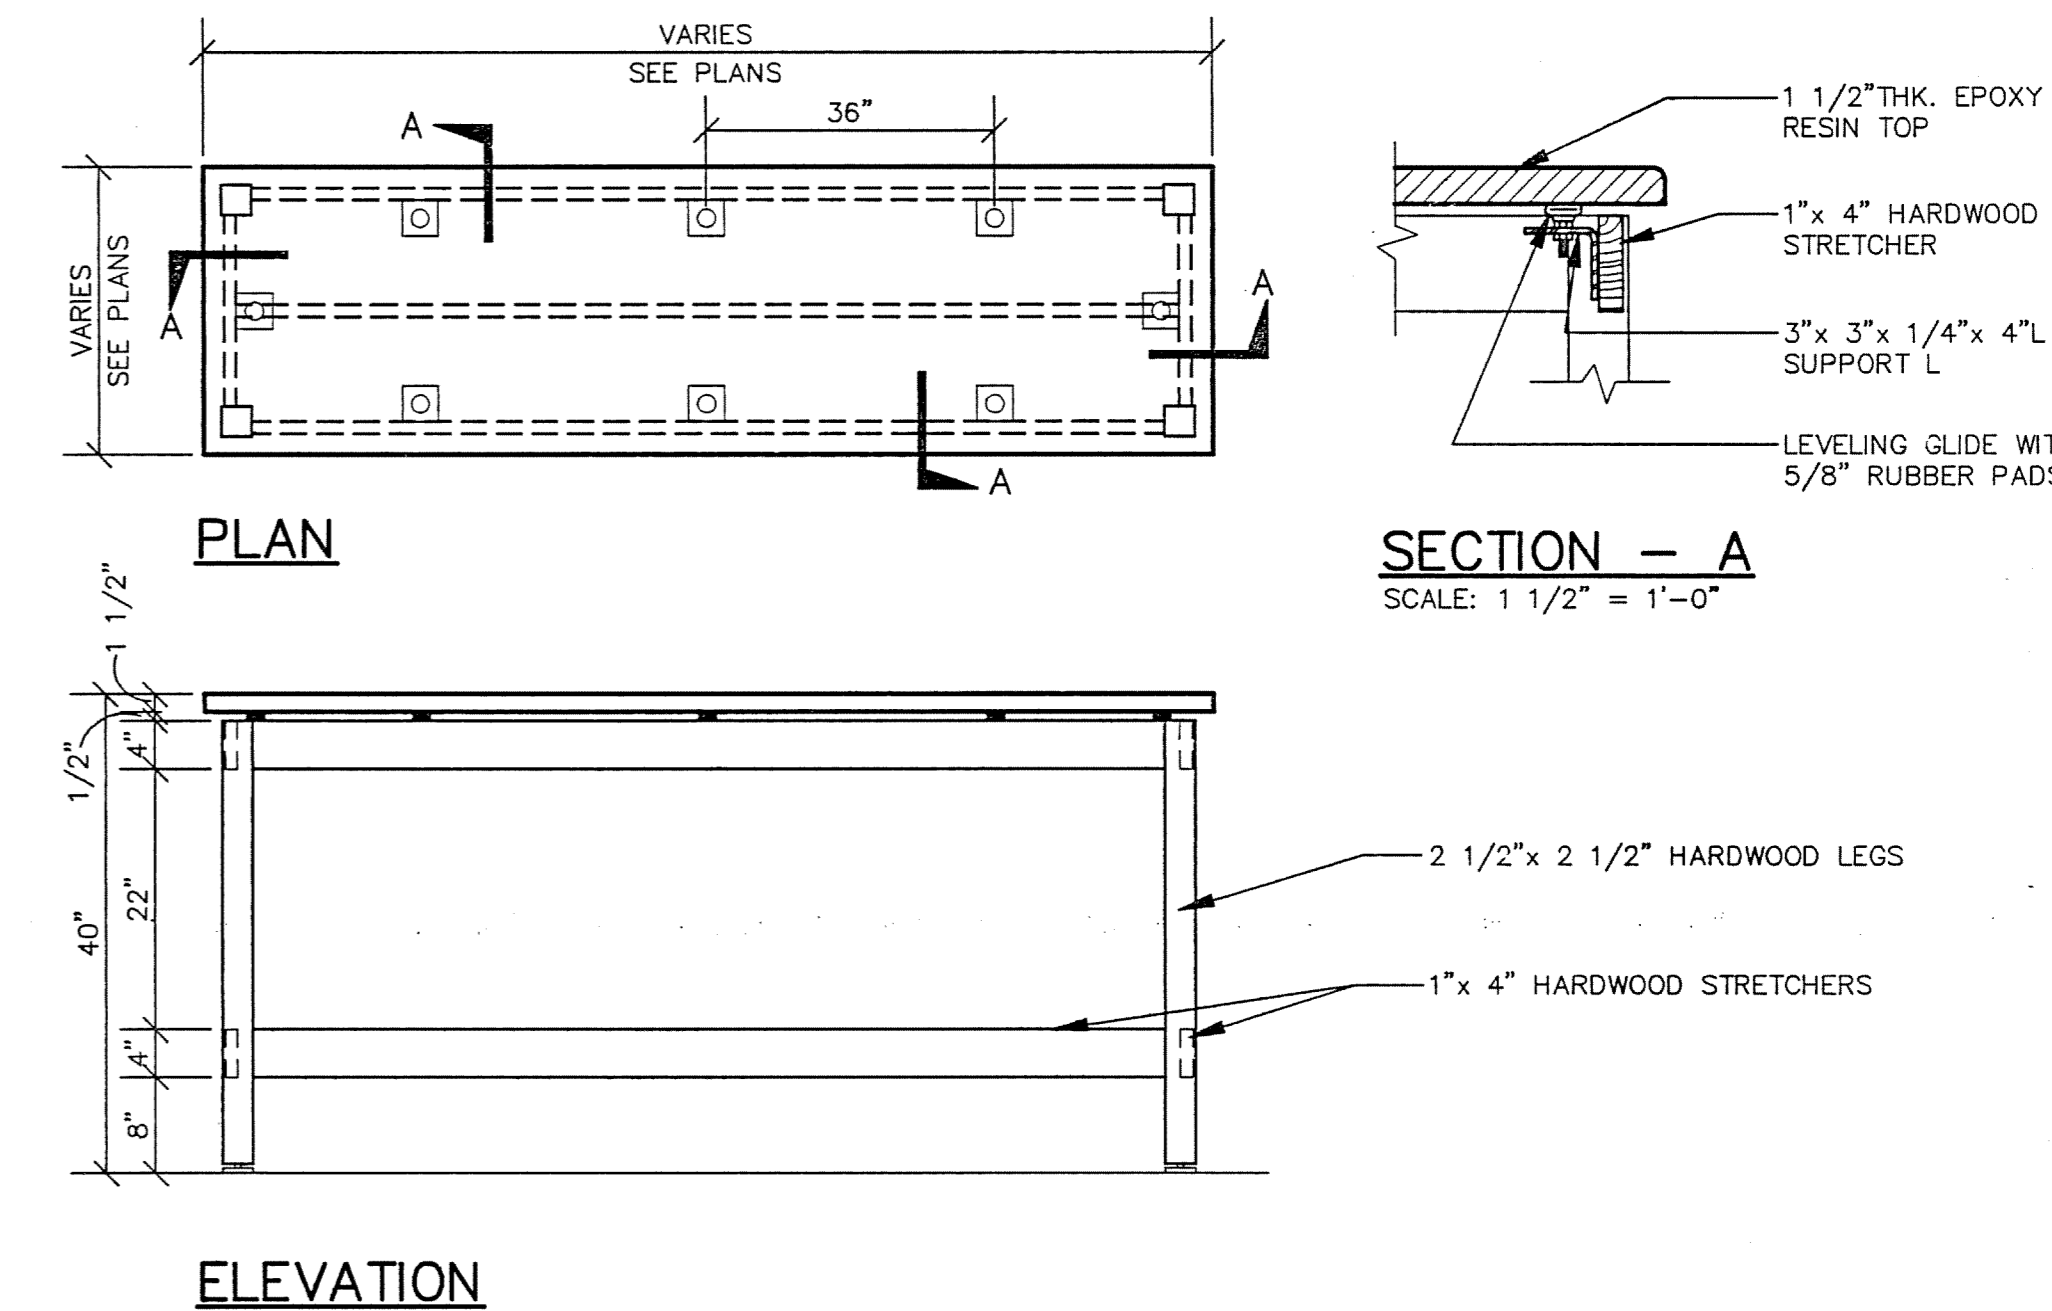

PLAN

ELEVATION

# 5 CYLINDER RACK DETAIL

SCALE: 3/4" = 1'-0"

EARL WALLS ASSOCIATES © 1994

# 6 VACUUM CABINET DETAIL

SCALE: 3/4" = 1'-0"

EARL WALLS ASSOCIATES © 1994

# 7 PULL-OUT ADJUSTABLE SHELVING


SCALE: NONE

EARL WALLS ASSOCIATES © 1994


# 8 BALANCE TABLE - HEAVY DUTY CONSTRUCTION

SCALE: 3/4" = 1'-0"

EARL WALLS ASSOCIATES © 1994

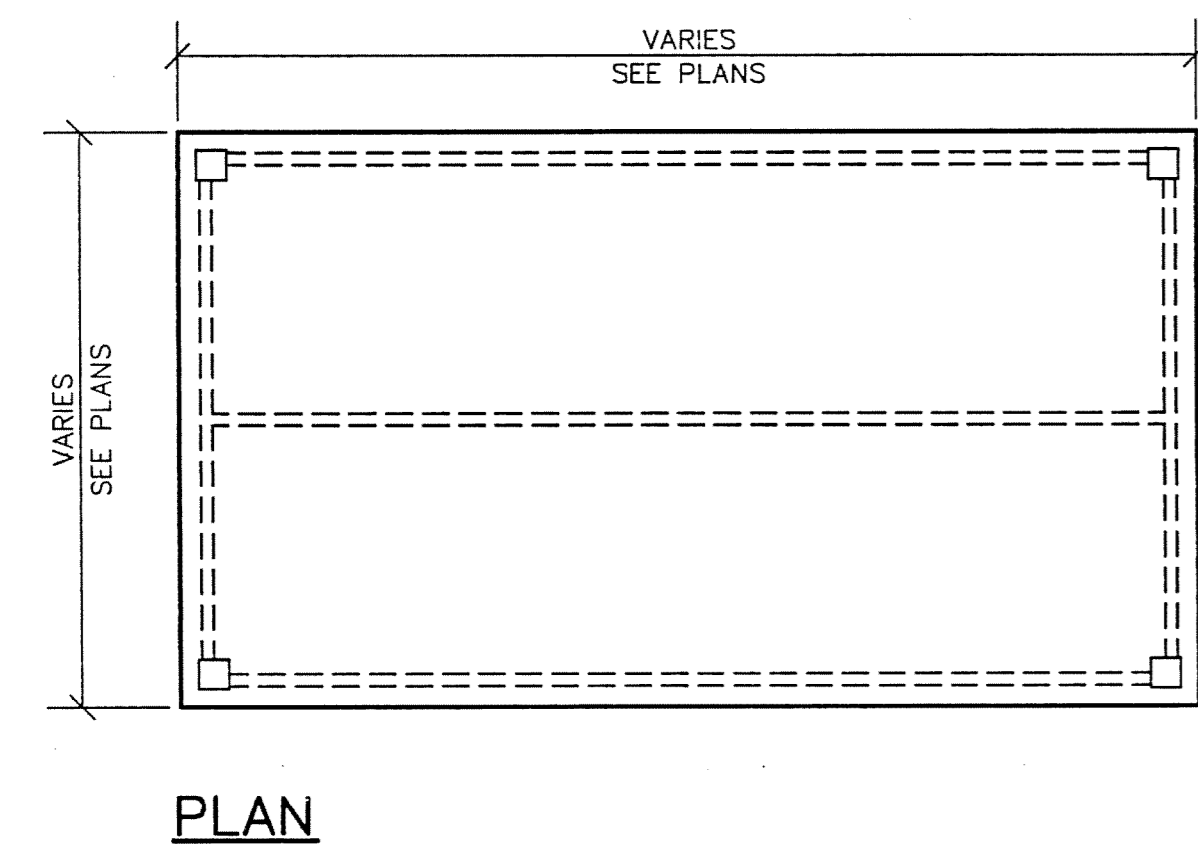

PLAN

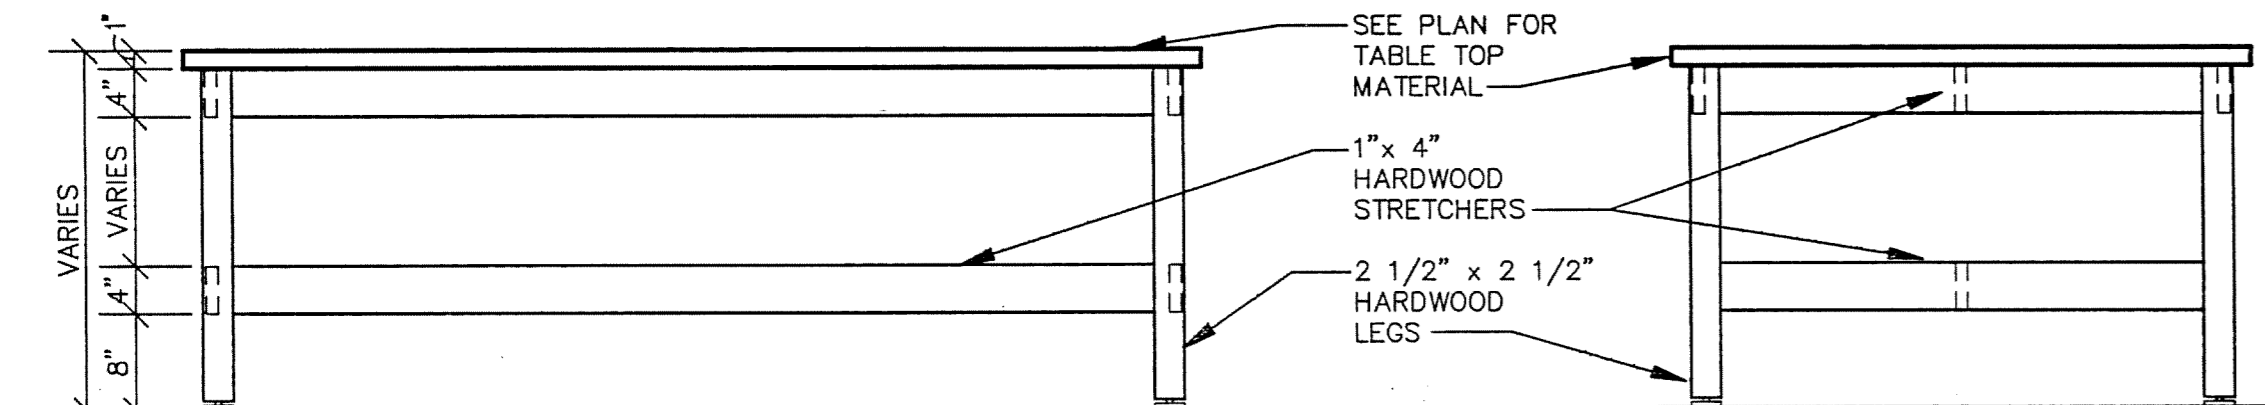


FRONT ELEVATION

SIDE ELEVATION

# 9 HEAVY DUTY TABLE

SCALE: 3/4" = 1'-0"

EARL WALLS ASSOCIATES © 1994

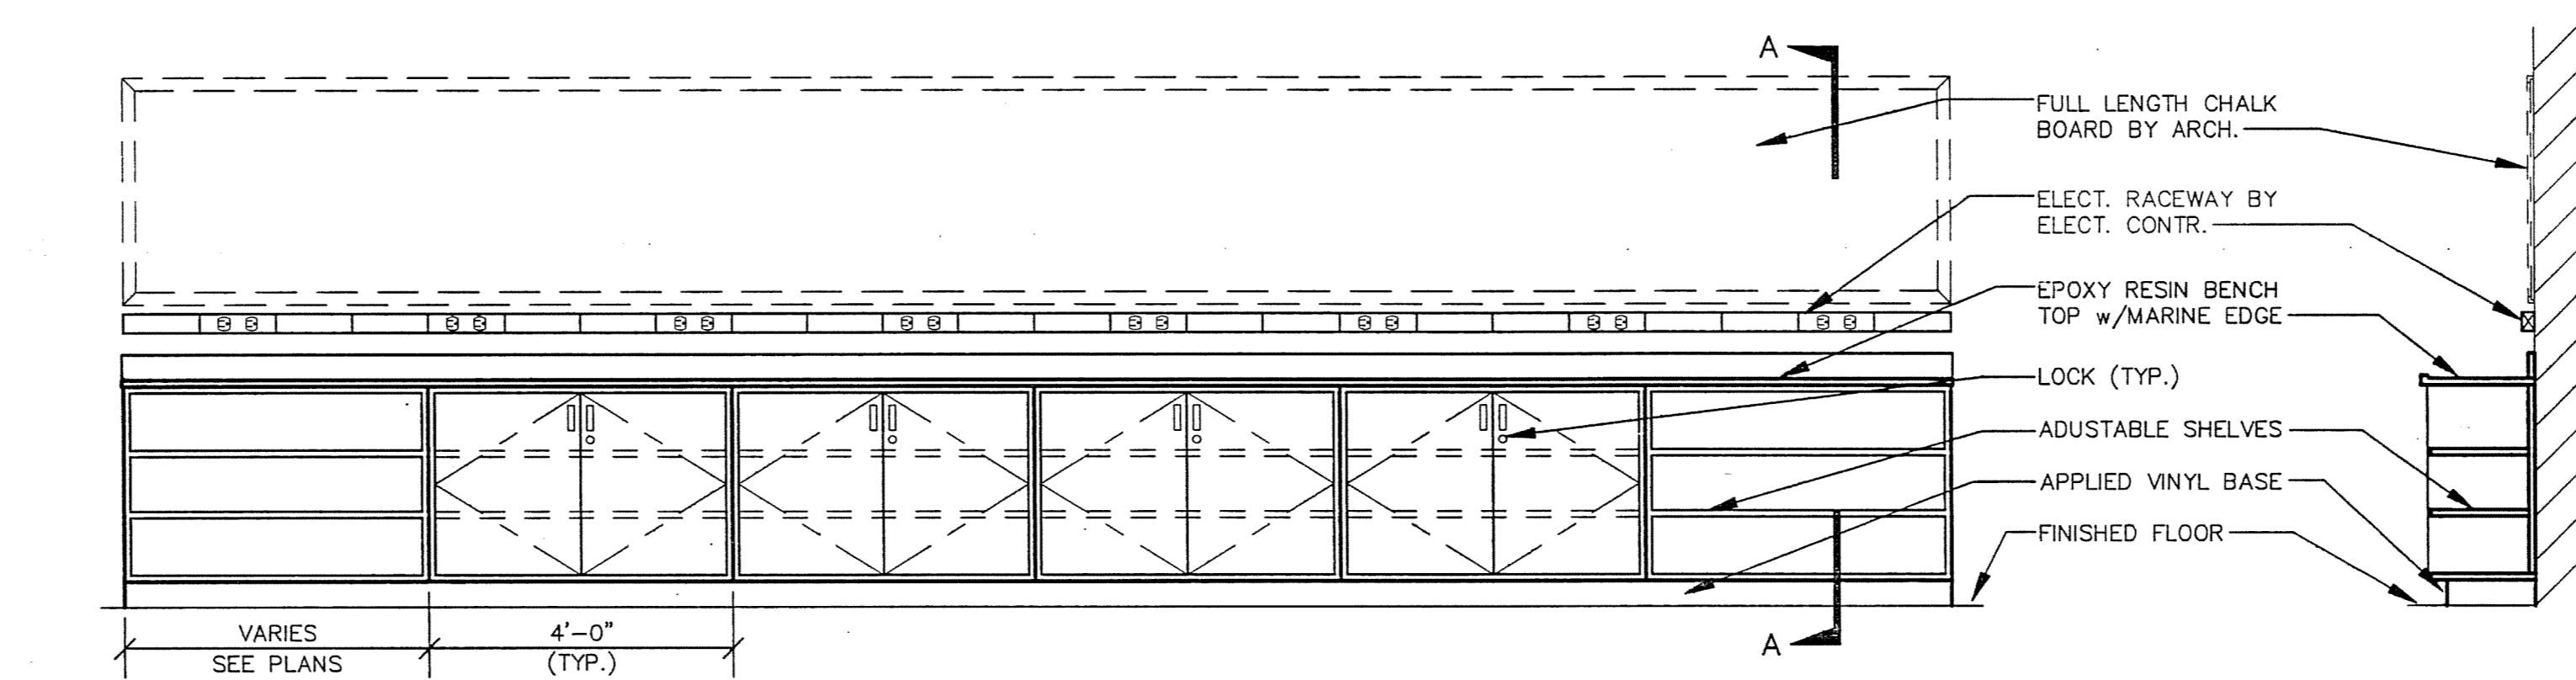


PLAN

SECTION - A

# 10 CHEMICAL DISPENSING COUNTER DETAIL

SCALE: 1/2" = 1'-0"

EARL WALLS ASSOCIATES © 1994

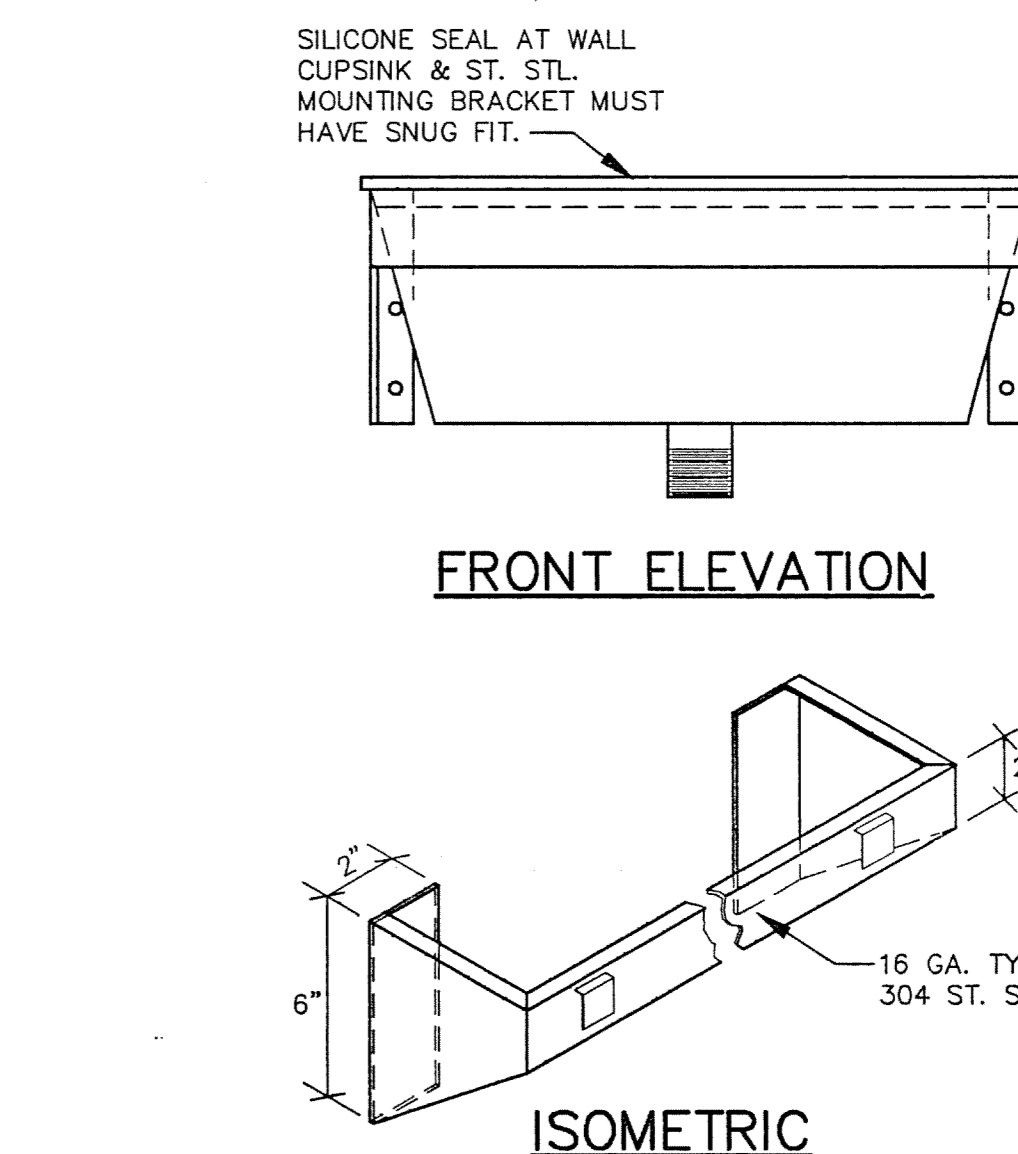


FRONT ELEVATION

ISOMETRIC

# 11 ST. STL. MOUNTING BRACKET FOR WALL MOUNTED CUPSINK

NOT TO SCALE

AS BUILT

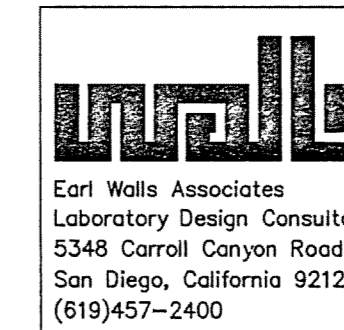

DRAWING REVISIONS:		
NO.	DATE	REMARKS

DATE: 5/16/94  
PROJECT#: 8962  
DESIGNED BY: PJK  
DRAWN BY: MGM, DCK  
CHECKED BY: PJK  
CHECKED BY:

SHEET NO.:

LF13