



JEFFERIES AND FARIS  
ASSOCIATES  
ARCHITECTS • PLANNERS  
SEA TOWERS, SUITE 201  
2002 EASTWOOD ROAD  
WILMINGTON, N.C. 28403  
TEL: 910.256.6633  
FAX: 910.256.9088

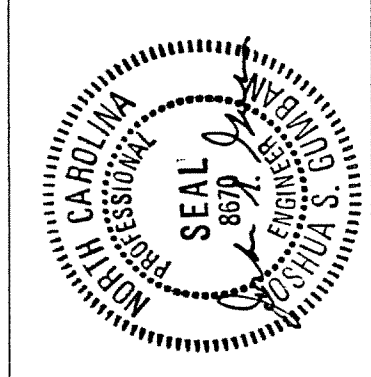


SCIENCE BUILDING  
UNIVERSITY OF NORTH CAROLINA AT WILMINGTON  
CODE 49388 ITEM 301 ID#6084280301A

SHEET TITLE:

SECOND FLOOR PLAN - AREA FOUR  
EAST

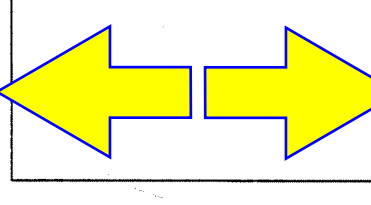


SHEET NO.:  
**LF9**

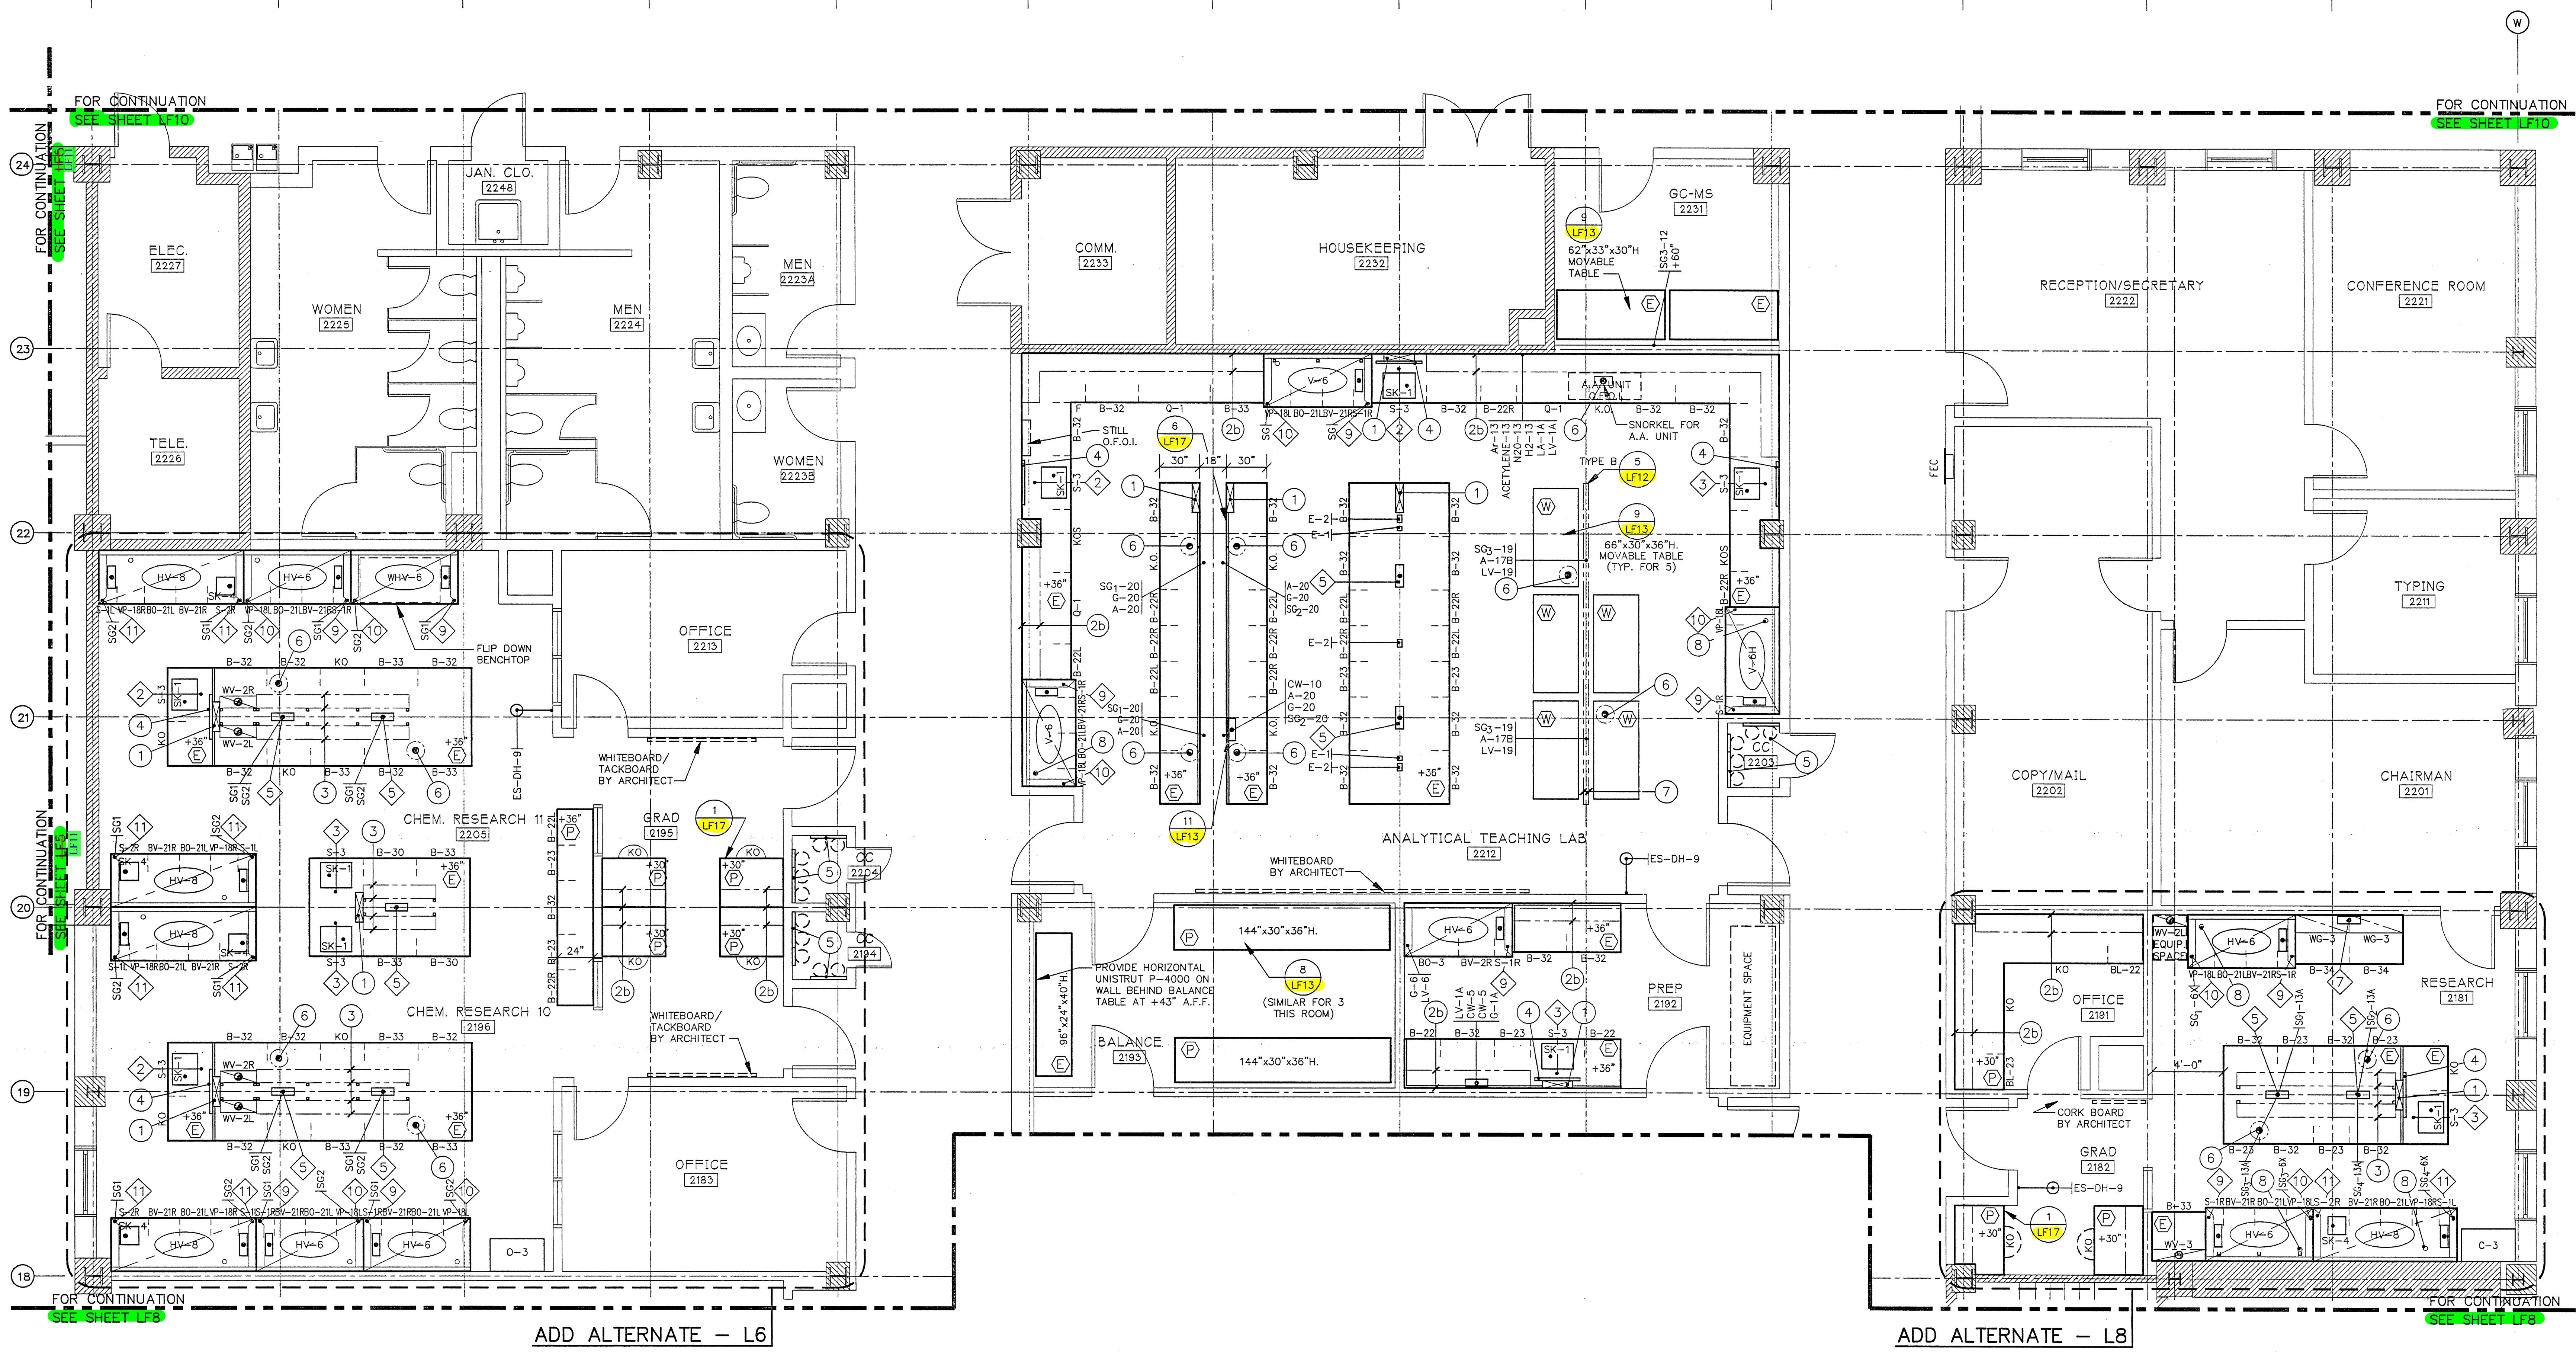

SERVICE FITTING SCHEDULE

EXAMPLE:  
G-1A INDICATES TYPE OF FITTING ABBREVIATED INDIVIDUALLY ON FLOOR PLANS.  
LA-10 NUMERICAL REFERENCE OF FITTING ELEV. SEE DRAWING LF-16.  
FITTINGS MAY ALSO BE INDICATED INDIVIDUALLY ON FLOOR PLANS.  
A = 7" IF B = 21" OR LESS  
A = 9" IF B > 21"

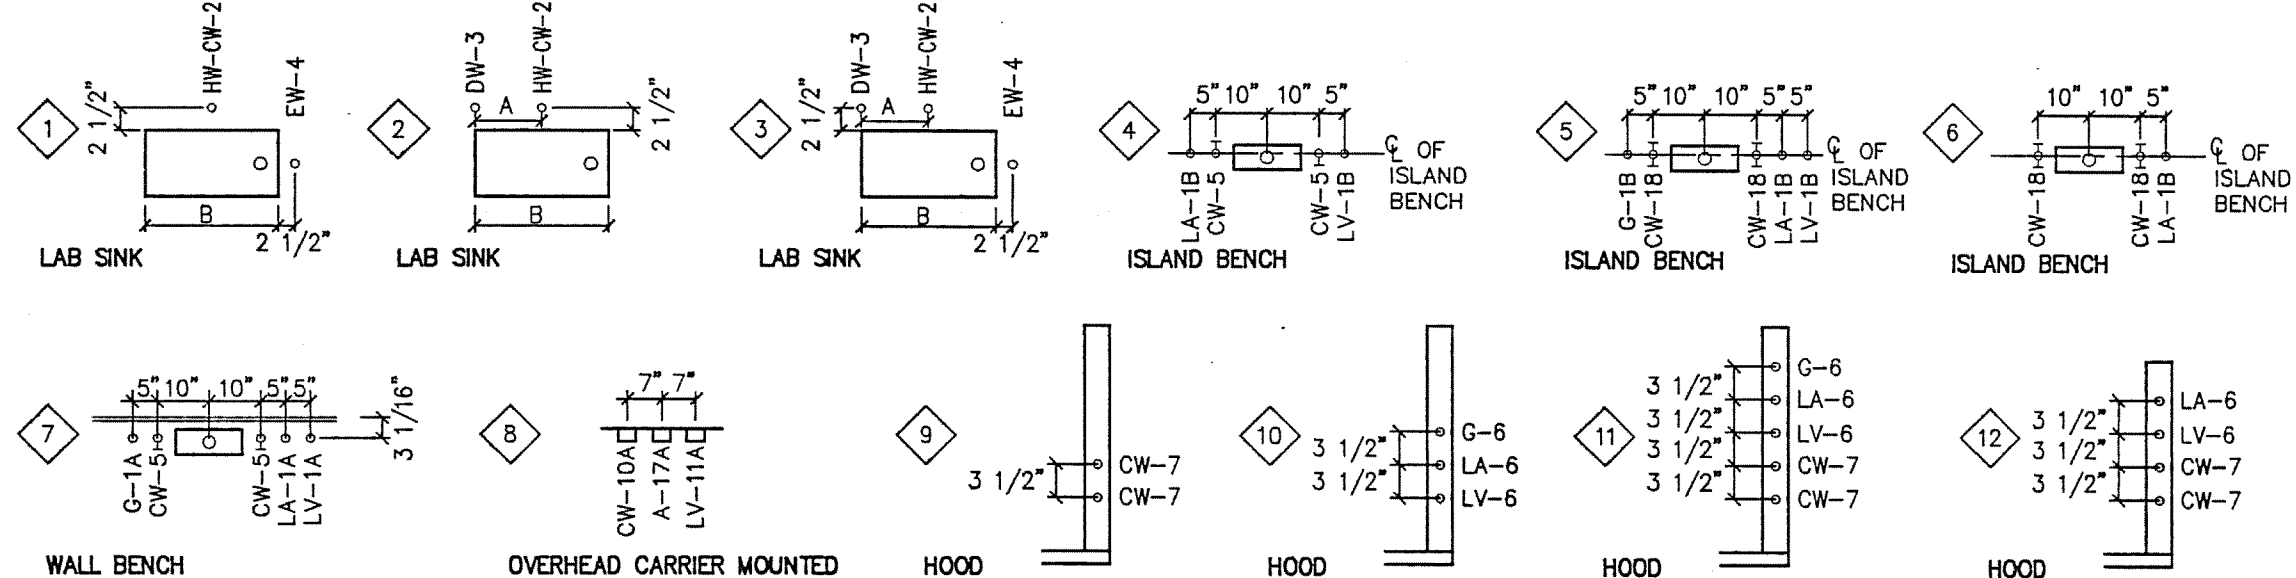

SECOND FLOOR  
SCALE: 1/4" = 1'-0"

AREA FOUR  
AS BUILT



DRAWING REVISIONS:		
NO.	DATE	REMARKS

DATE: 5/16/94  
PROJECT#: 8962  
DESIGNED BY: PJK  
DRAWN BY: LRH/DCK  
CHECKED BY: PJK  
CHECKED BY: