




CLANCY & THEYS CONSTRUCTION COMPANY	
<input checked="" type="checkbox"/> NO EXCEPTIONS NOTED	<input type="checkbox"/> MAKE CORRECTIONS NOTED
<input type="checkbox"/> REQUEST	<input type="checkbox"/> REVISE AND RESUBMIT

Reviewed for general conformance with the concept of the project and the submittal documents. This review does not relieve the subcontractor/supplier of the responsibility for making the work conform to the requirements of the contract, including all dimensions, quantities, correct fabrication and accurate fit with the work of other trades.



BY: [Signature] DATE: 2/26/95

REFER TO ARCHT. DRWG.			
		HARTMANN - SANDERS COLUMN CO. 4340 BANKERS CIRCLE ATLANTA, GEORGIA 30360 Architectural Wood Columns 404-449-1561	
SUBJECT	F.S. DETAIL OF COLUMNS		REVISIONS
PROJECT	SCIENCE BLDG - CMC		
CONTRACTOR			APPROVAL
ARCHITECT			
ORDER NO.	DRAWN BY	DISTRIBUTION	SHEET NO.
	D.K.	16 APRIL 1982	1 of 2
	DATE		
	4/27/84		

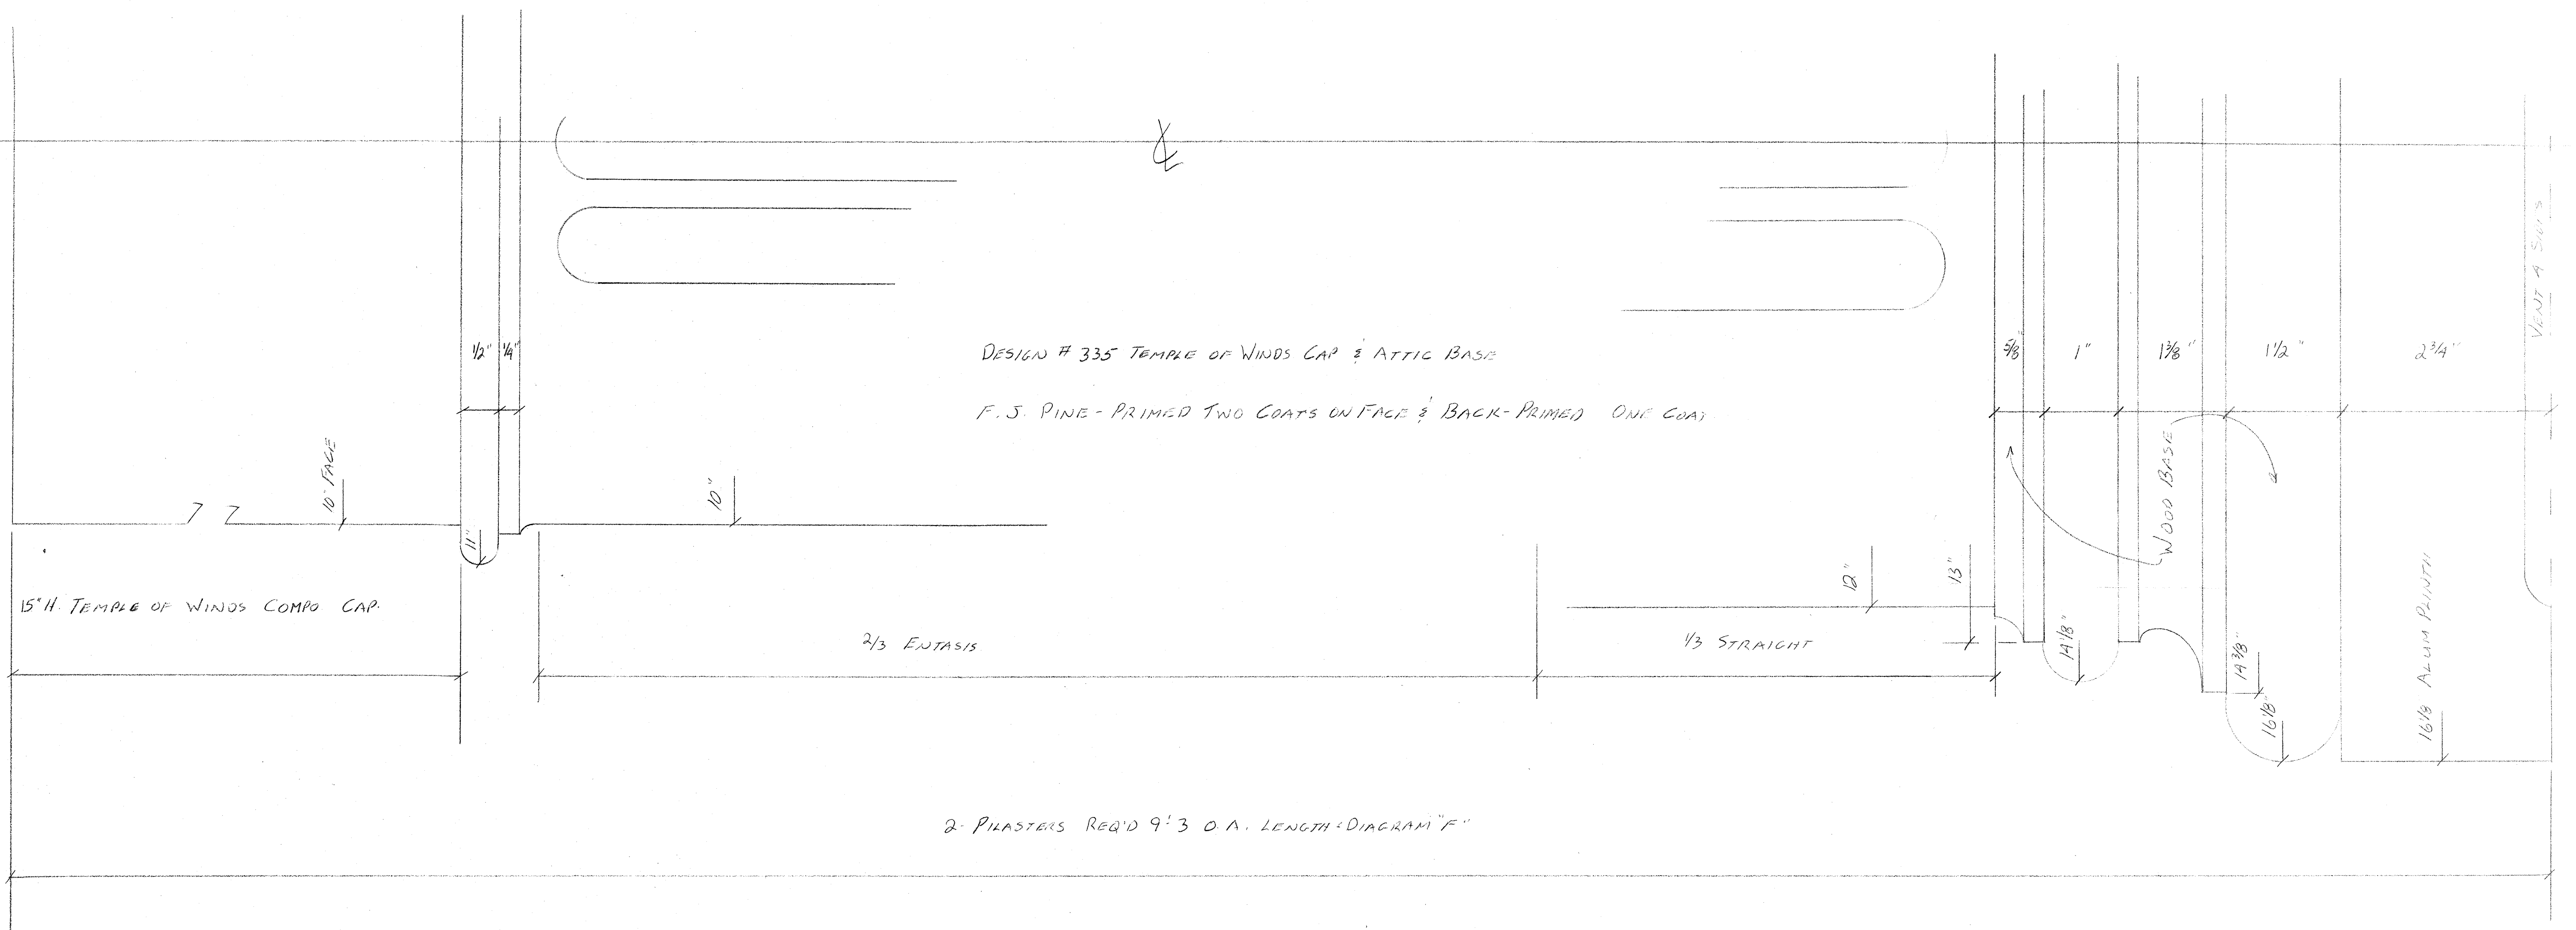

STEPHENSON MILLWORK CO. INC.

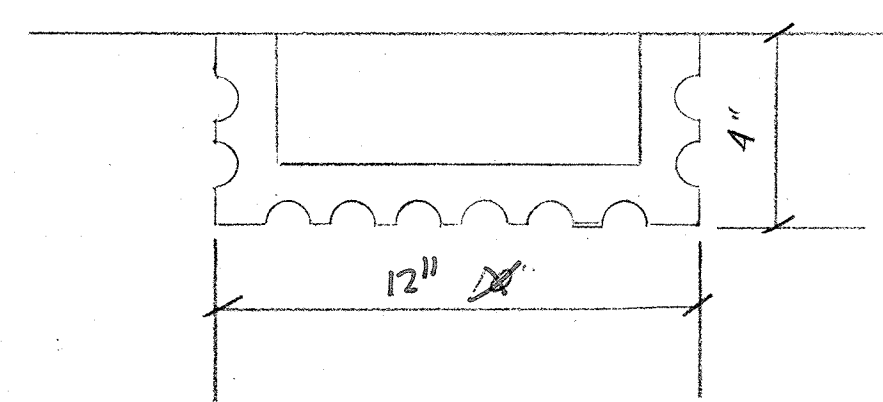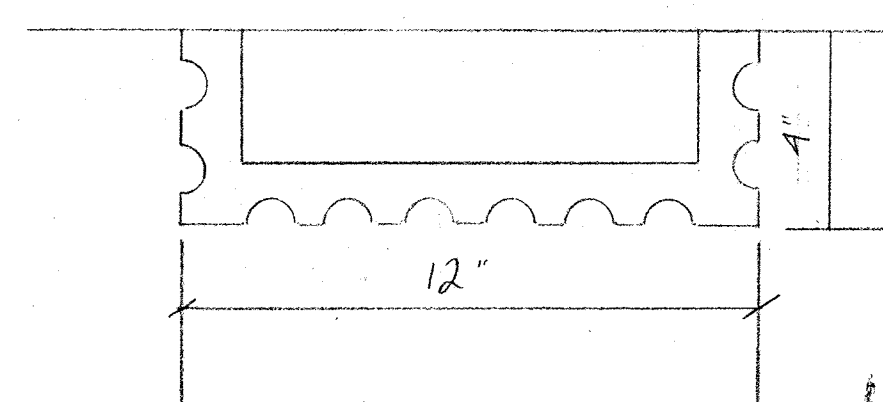

PLAN OF PILASTERS 3" = 1'-0"
PLEASE VERIFY 4" PROJECTION FROM WALL



STEPHENSON MILLWORK CO. INC.

REFER TO ARCH'T. DRW'G.					
		HARTMANN - SANDERS COLUMN CO. 4340 BANKERS CIRCLE ATLANTA, GEORGIA 30360 Architectural Wood Columns 404-449-1561			
SUBJECT	F.S. DETAIL OF PILASTERS			REVISIONS	
PROJECT	SCIENCE Bldg - UNIC				
CONTRACTOR				APPROVAL	
ARCHITECT					
ORDER NO.	DRAWN BY D.K. DATE 11-27-94			DISTRIBUTION 6 APRIL 11-27	
				SHEET NO. 2 of 2	