


- 1/2" CW (CAPPED)
- 1/2" CW
- 3/4" LV (CAPPED)
- 1/2" LA (CAPPED)
- 1/2" A (CAPPED)
- 1/2" G (CAPPED)
- 1/2" DW (CAPPED)
- 1/2" HW (CAPPED)

SERVICE FITTING SCHEDULE

EXAMPLE: 6-1A INDICATES TYPE OF FITTING ABBREVIATED INDIVIDUALLY ON FLOOR PLANS.
 LA-10- NUMERICAL REFERENCE OF FITTING ELEV. SEE DRAWING LF-16.
 FITTINGS MAY ALSO BE INDICATED AS: A = 7" IF B = 21" OR LESS
 A = 9" IF B > 21"

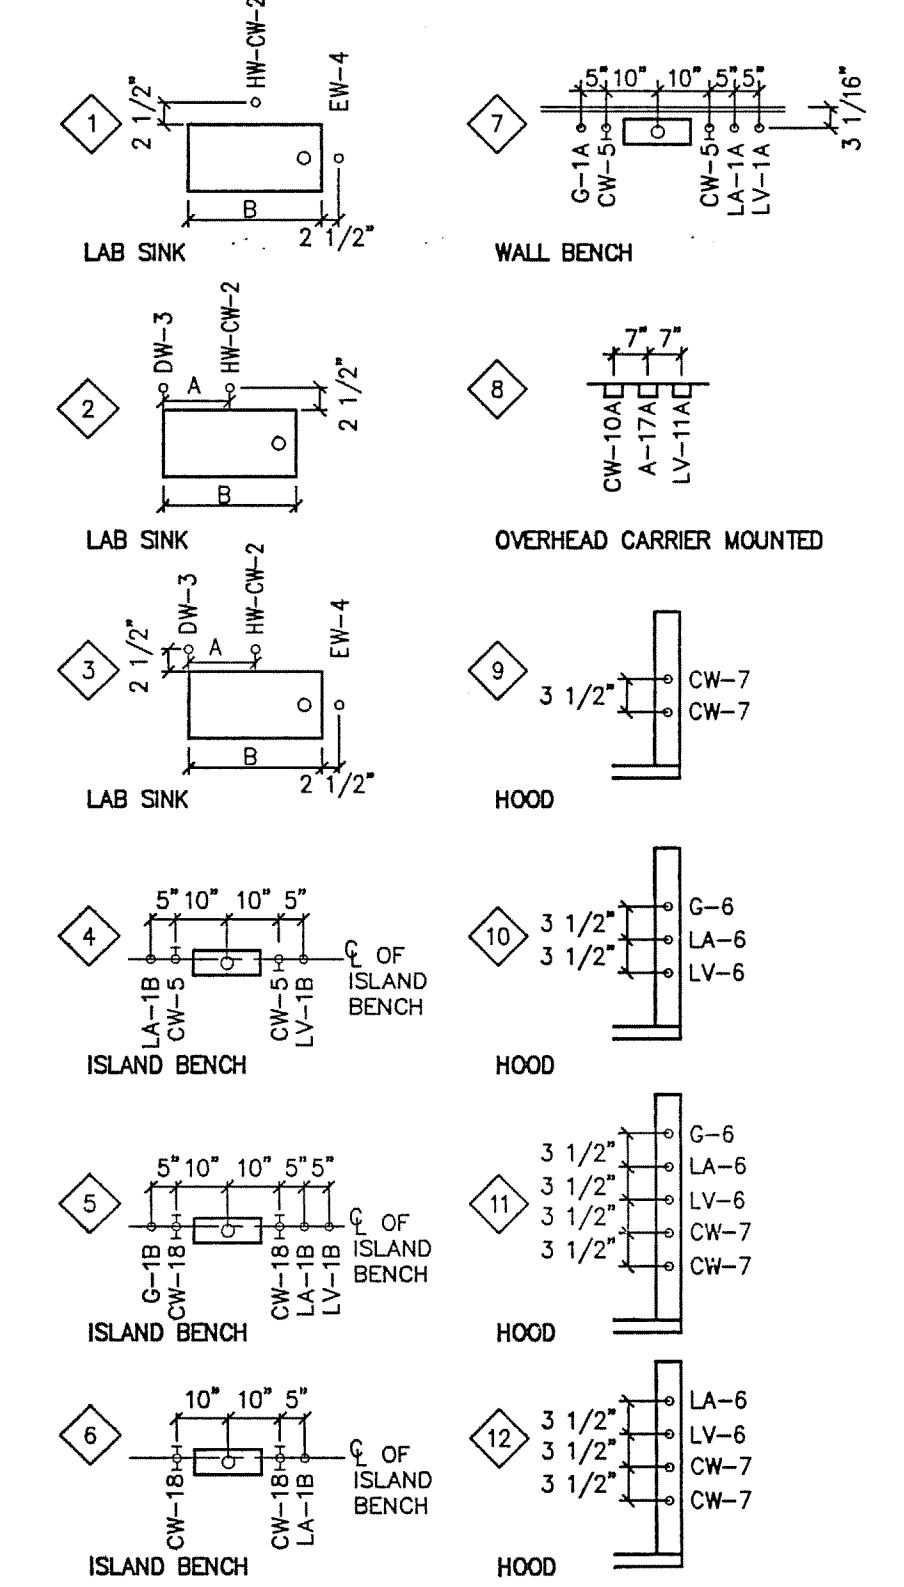

SECOND FLOOR
 SCALE: 1/4" = 1'-0"

AREA FIVE
 AS BUILT

WALL
 Earl Walls Associates
 Laboratory Design Consultants
 5348 Carroll Canyon Road
 San Diego, California 92121
 (619)457-2400


DRAWING REVISIONS:		
NO.	DATE	REMARKS

DATE: 5/16/94
 PROJECT#: 8962
 DESIGNED BY: AMA
 DRAWN BY: AMA
 CHECKED BY: ARW

SHEET NO.:
LP10

JEFFERIES AND FARIS ASSOCIATES
 ARCHITECTS • PLANNERS
 SEA TOWERS SUITE 201
 2002 EASTWOOD ROAD
 WILMINGTON, N.C. 28403
 TEL: 910.256.6633
 FAX: 910.256.9088

BUILDING KEYMAP

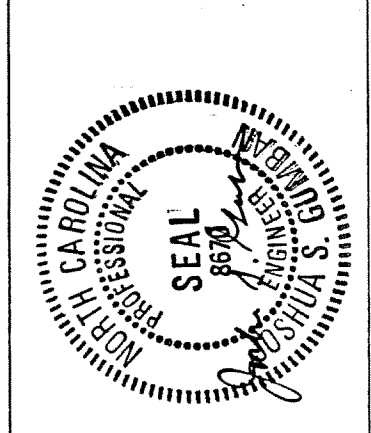

SCIENCE BUILDING
 UNIVERSITY OF NORTH CAROLINA AT WILMINGTON
 CODE 49300 ITEM 301 ID#6089280801A

SHEET TITLE:
 SECOND FLOOR PLAN - AREA FIVE
 EAST