



1 LAB PIPING AT WALL BENCH - ELEVATION  
NOT TO SCALE

EARL WALLS ASSOCIATES © 1994

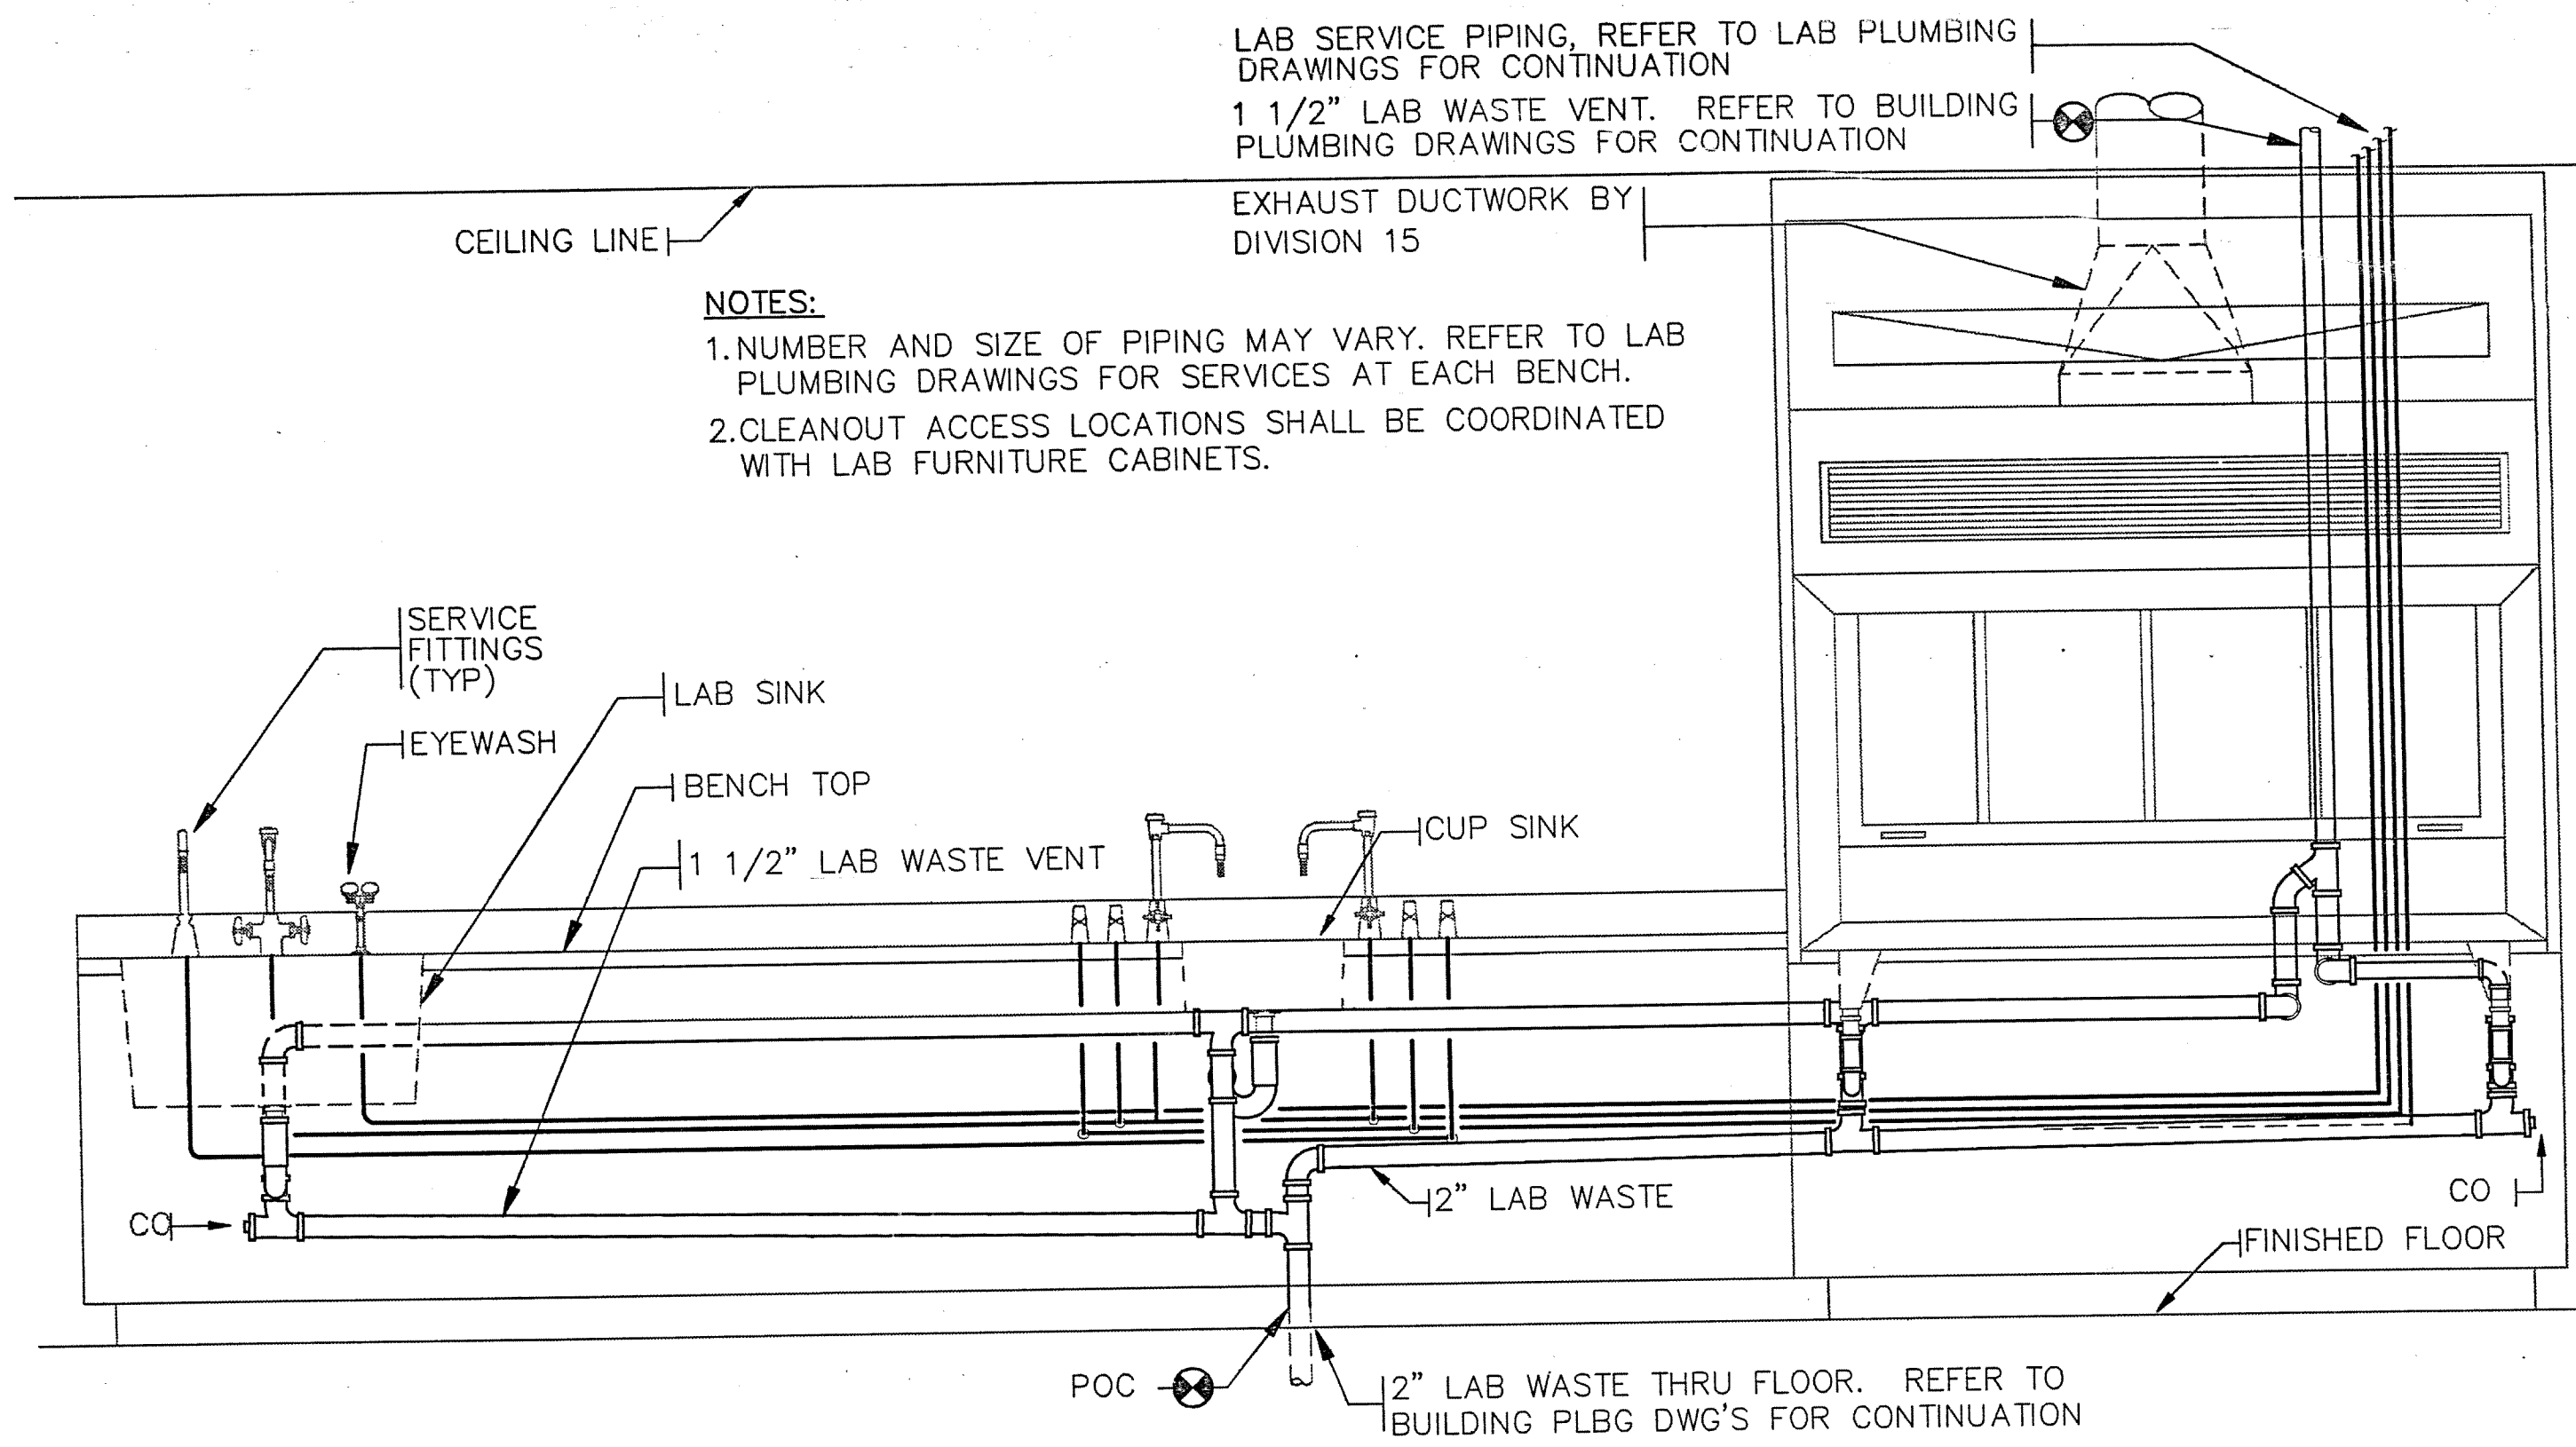


2 LAB PIPING AT WALL BENCH - ELEVATION  
NOT TO SCALE

EARL WALLS ASSOCIATES © 1994

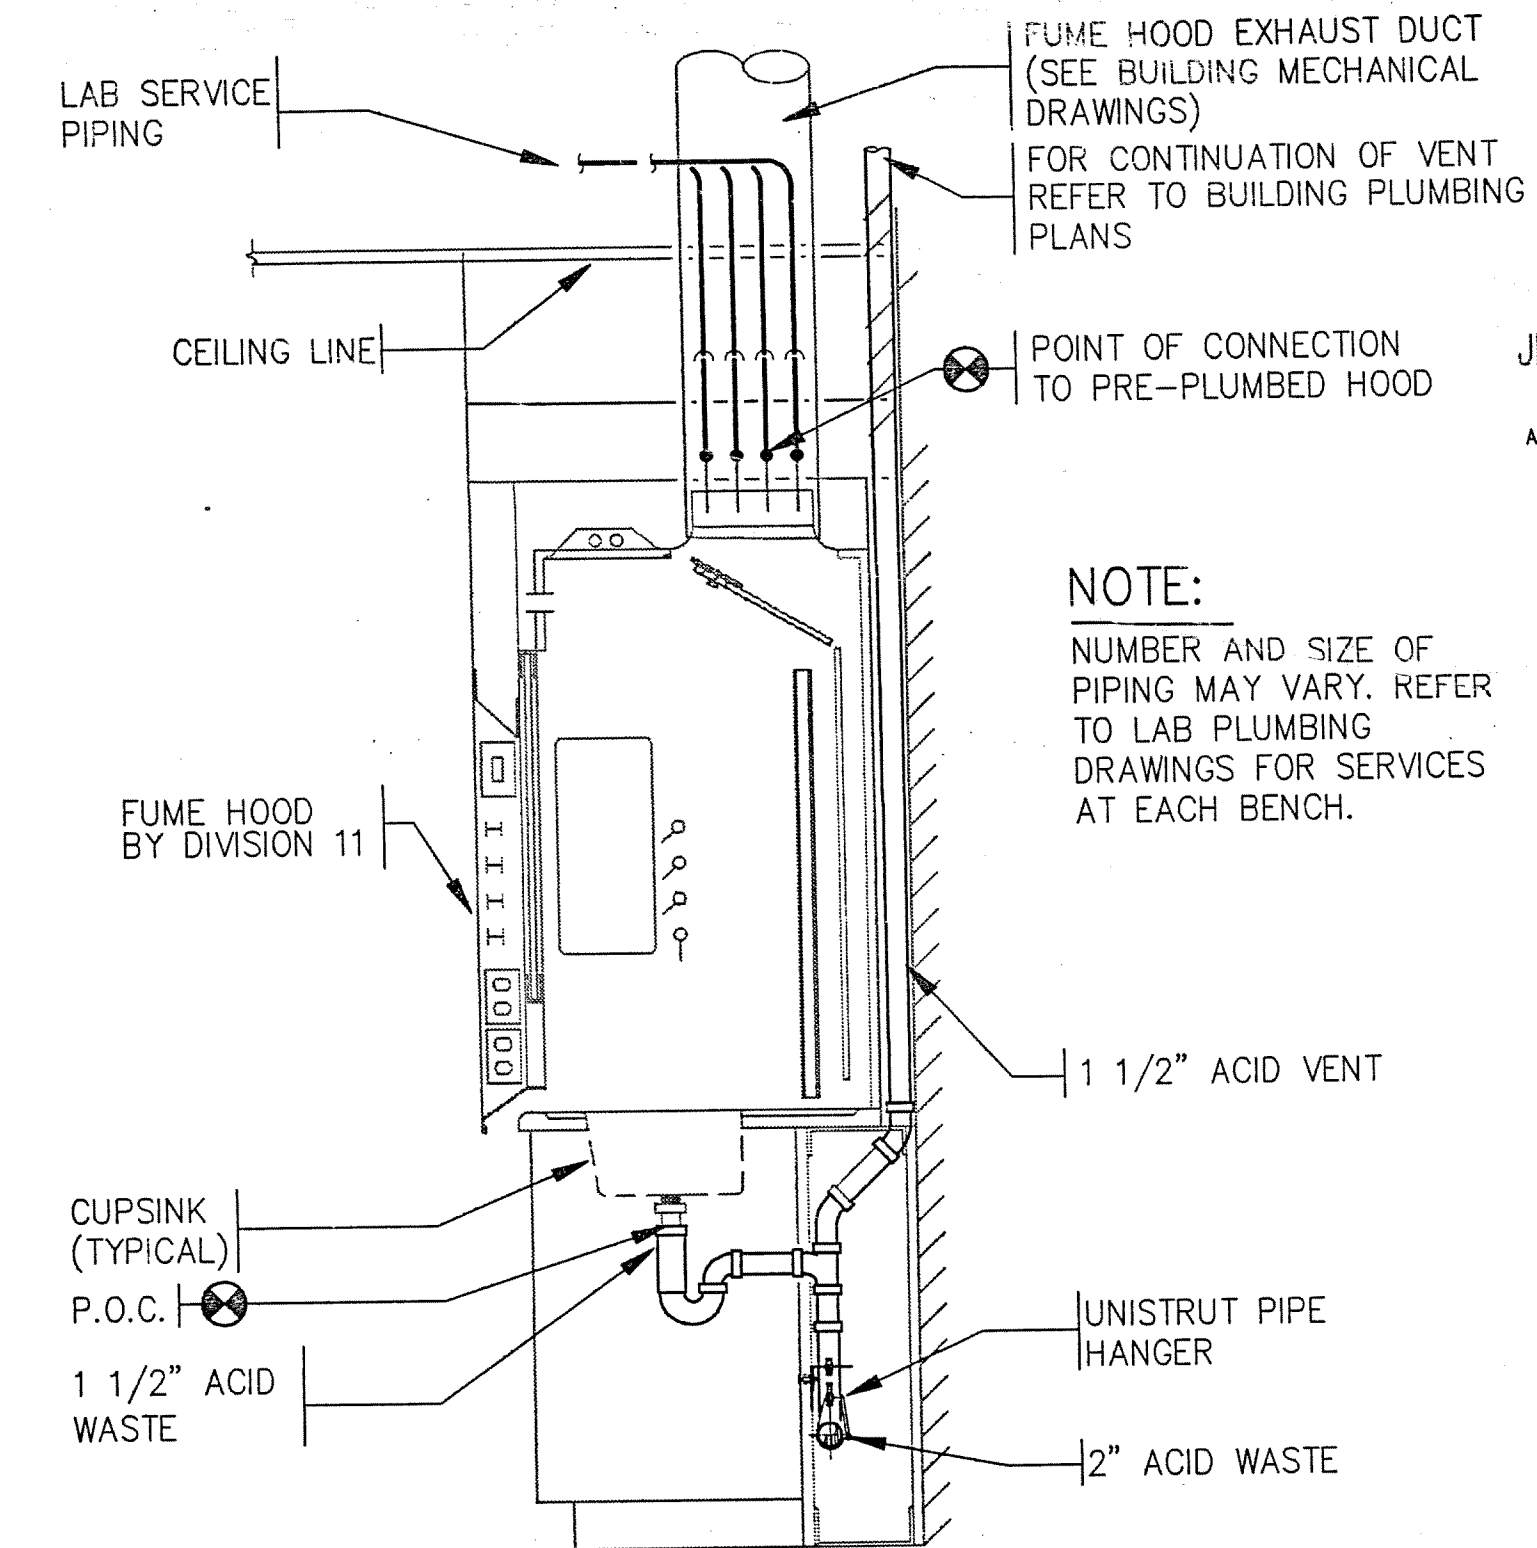


3 FUME HOOD AT WALL BENCH - SECTION  
NOT TO SCALE

EARL WALLS ASSOCIATES © 1994

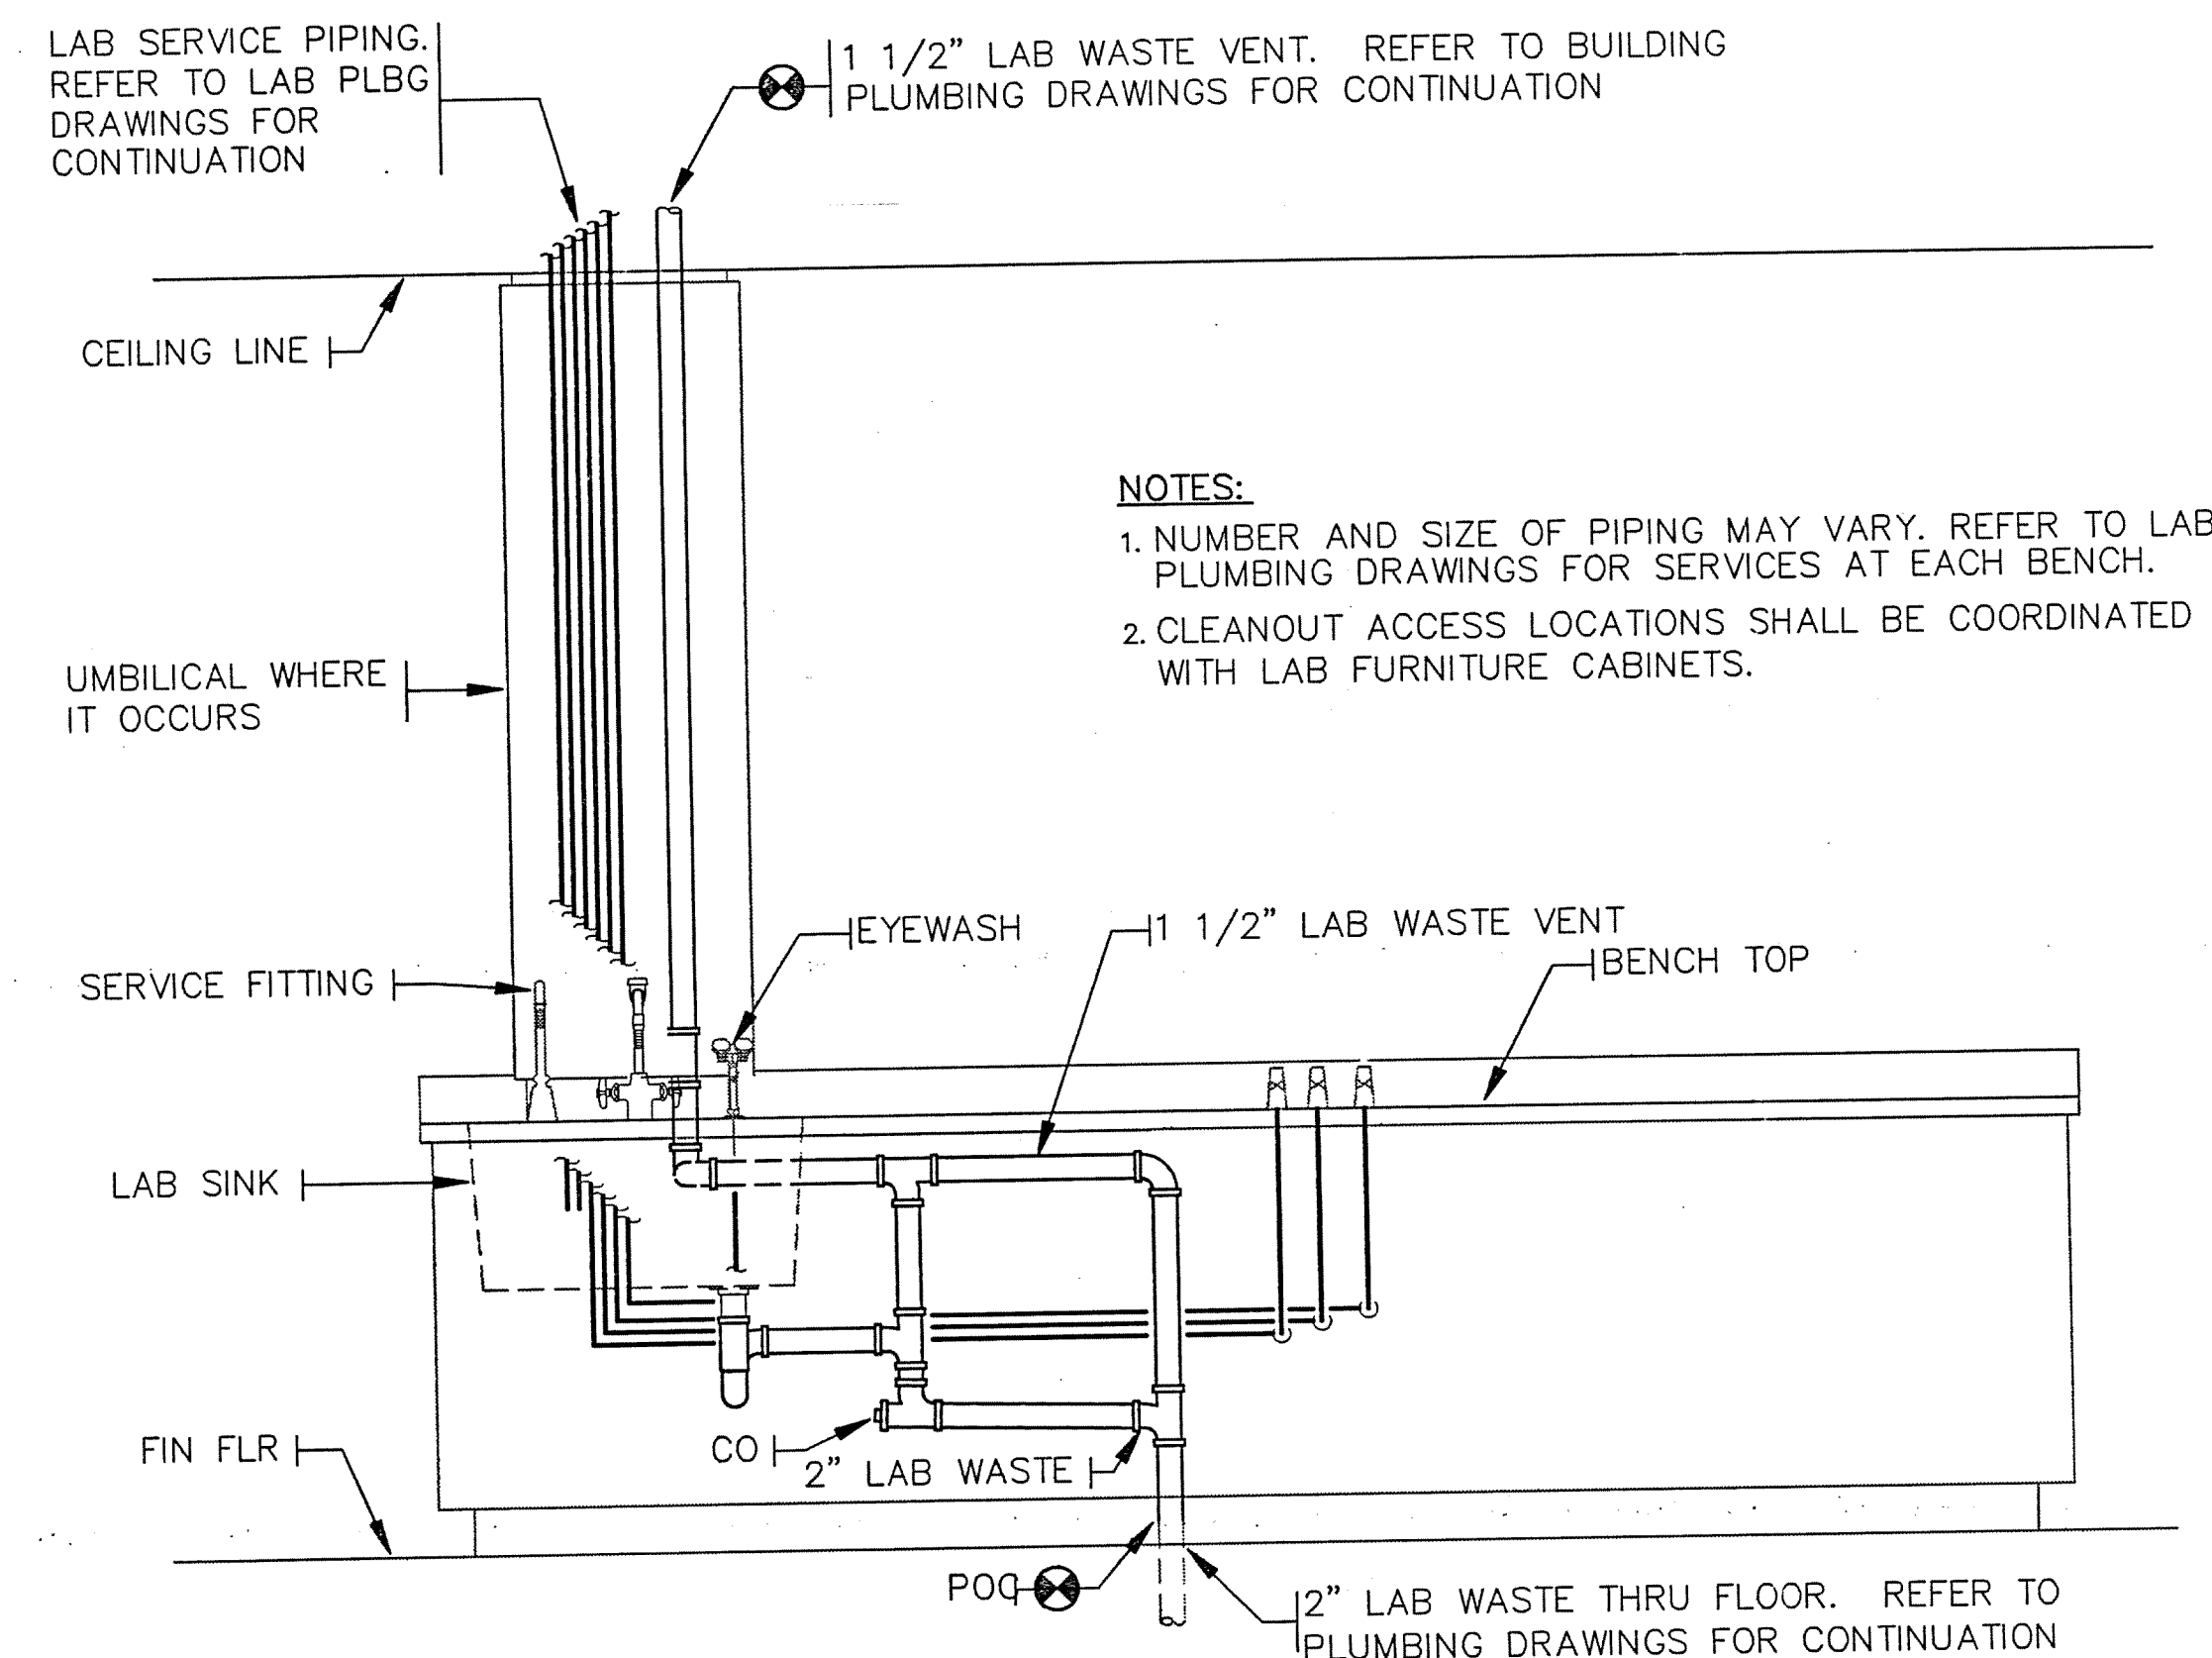


4 LAB PIPING AT WALL BENCH - ELEVATION  
NOT TO SCALE

EARL WALLS ASSOCIATES © 1991

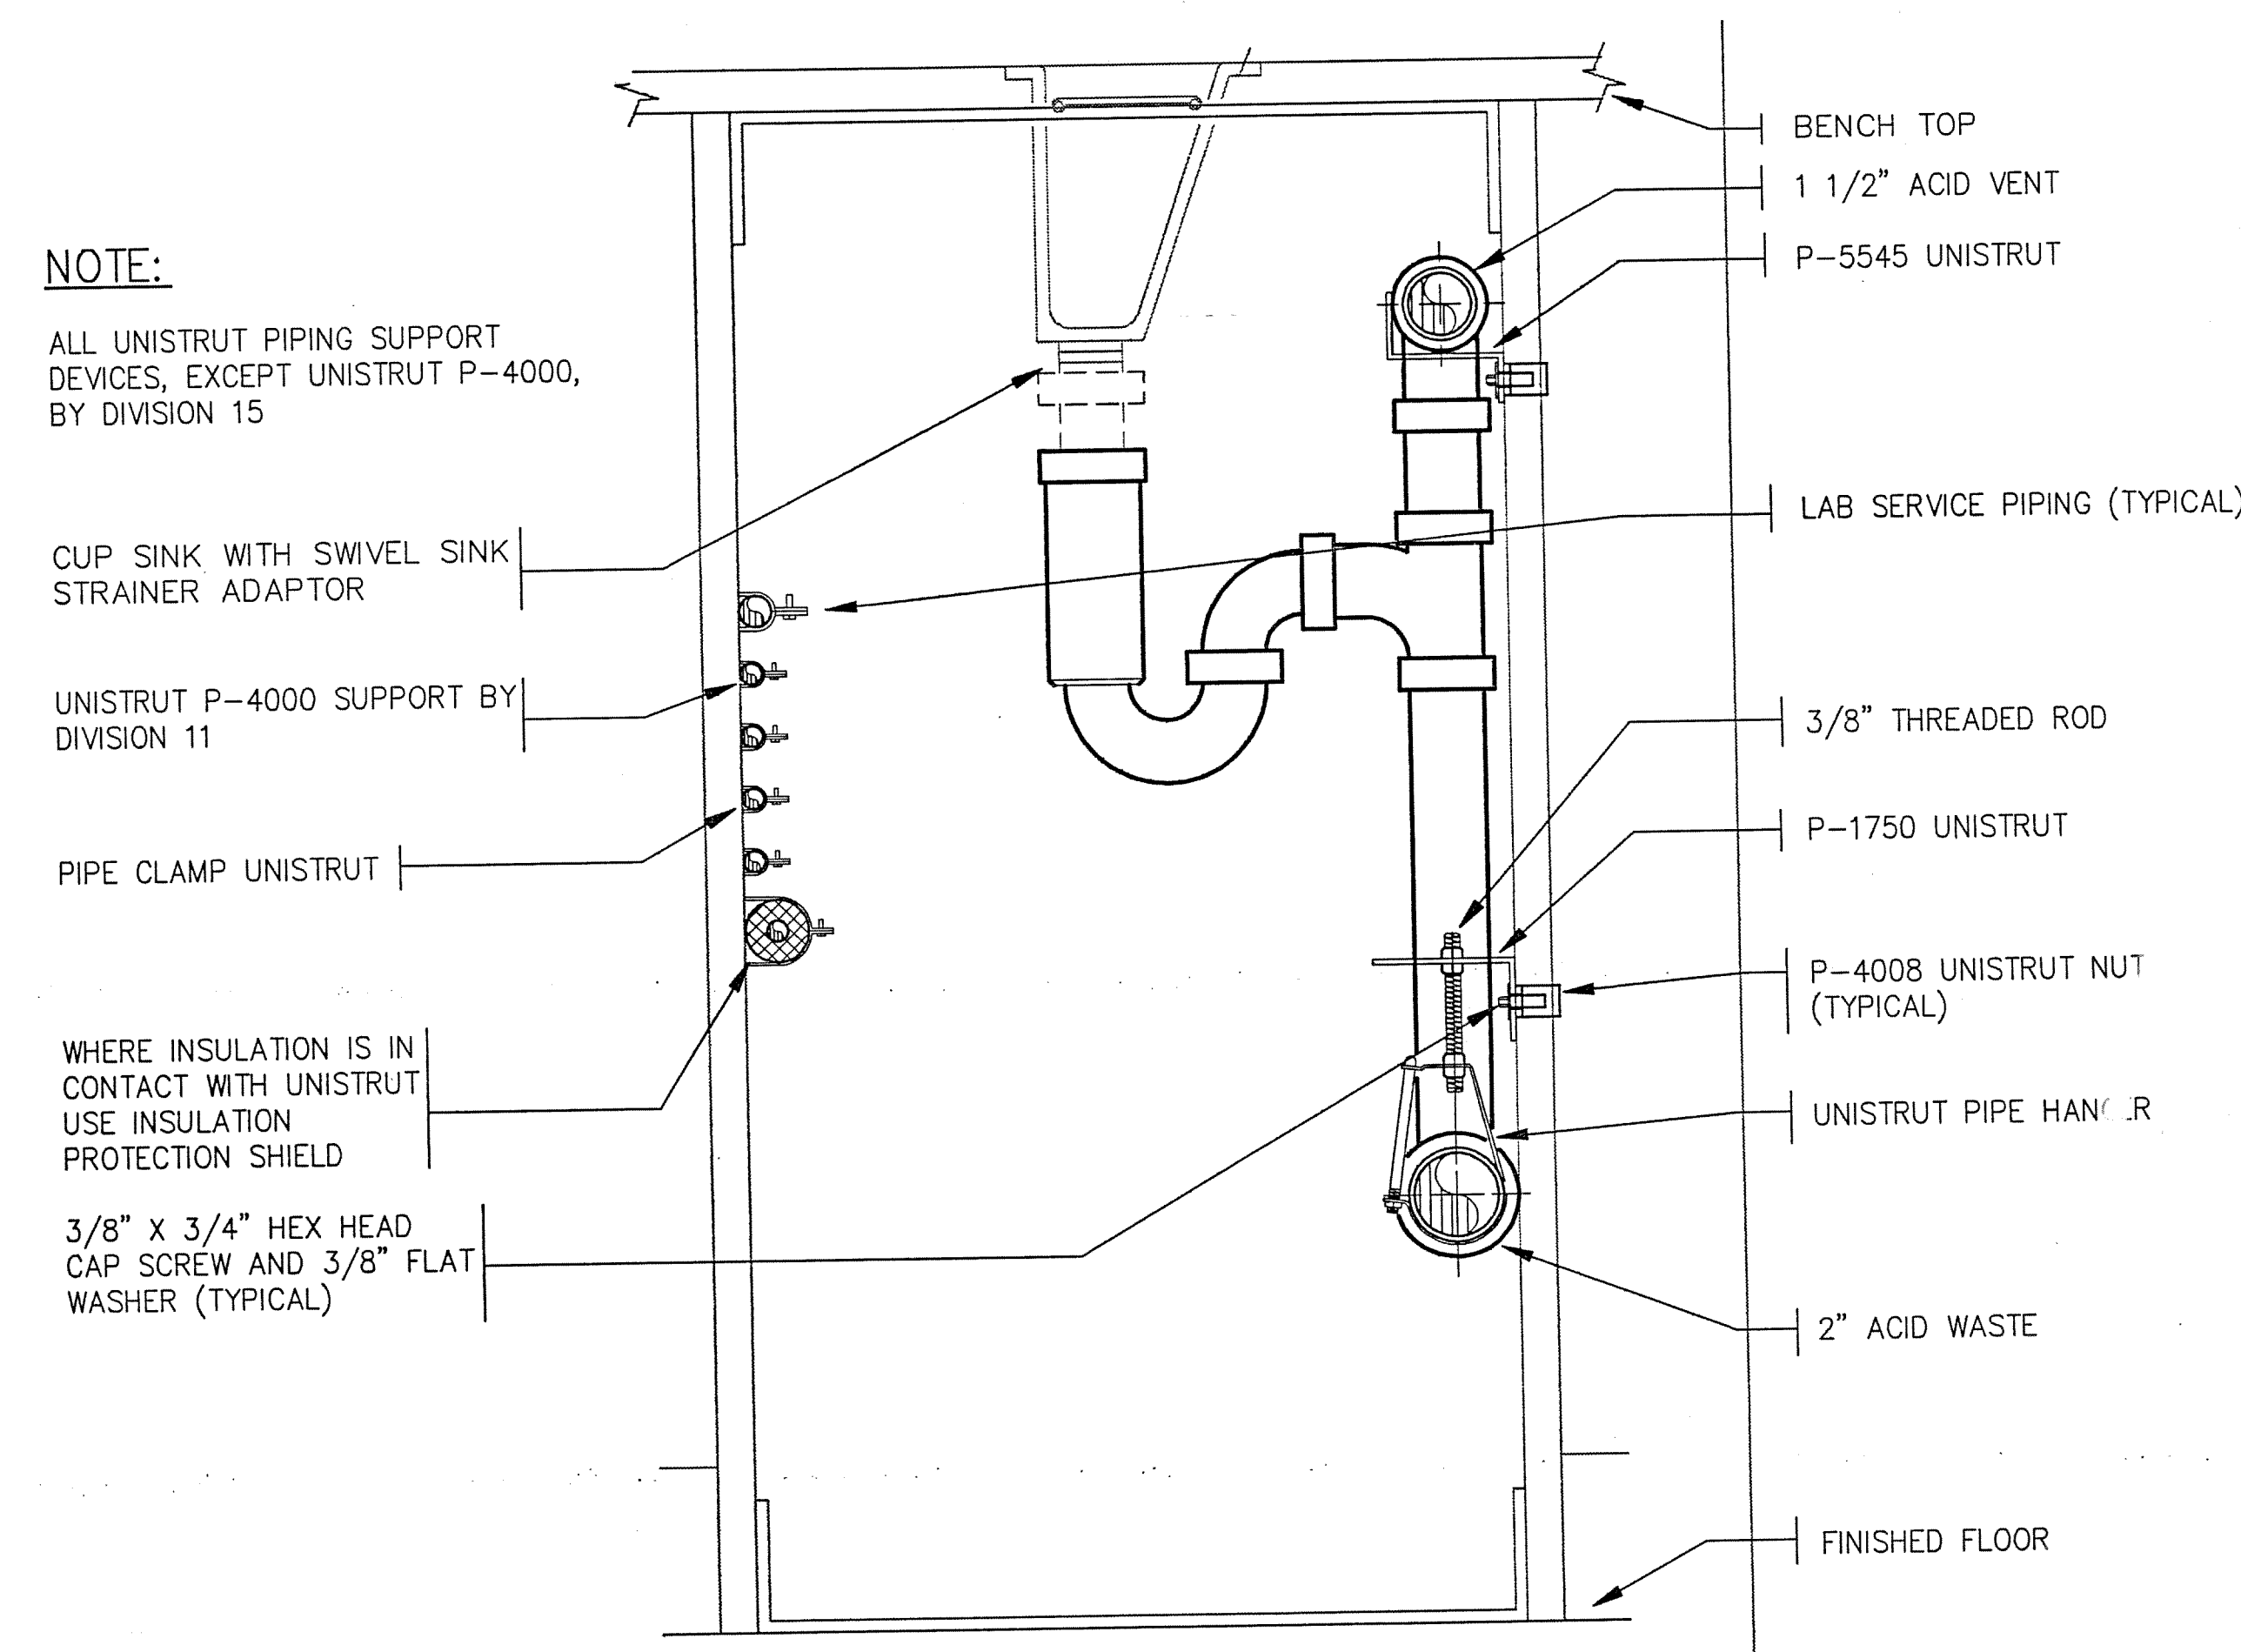

5 LAB PIPING AT ISLAND BENCH - PIPE CHASE SECTION  
NOT TO SCALE

EARL WALLS ASSOCIATES © 1994

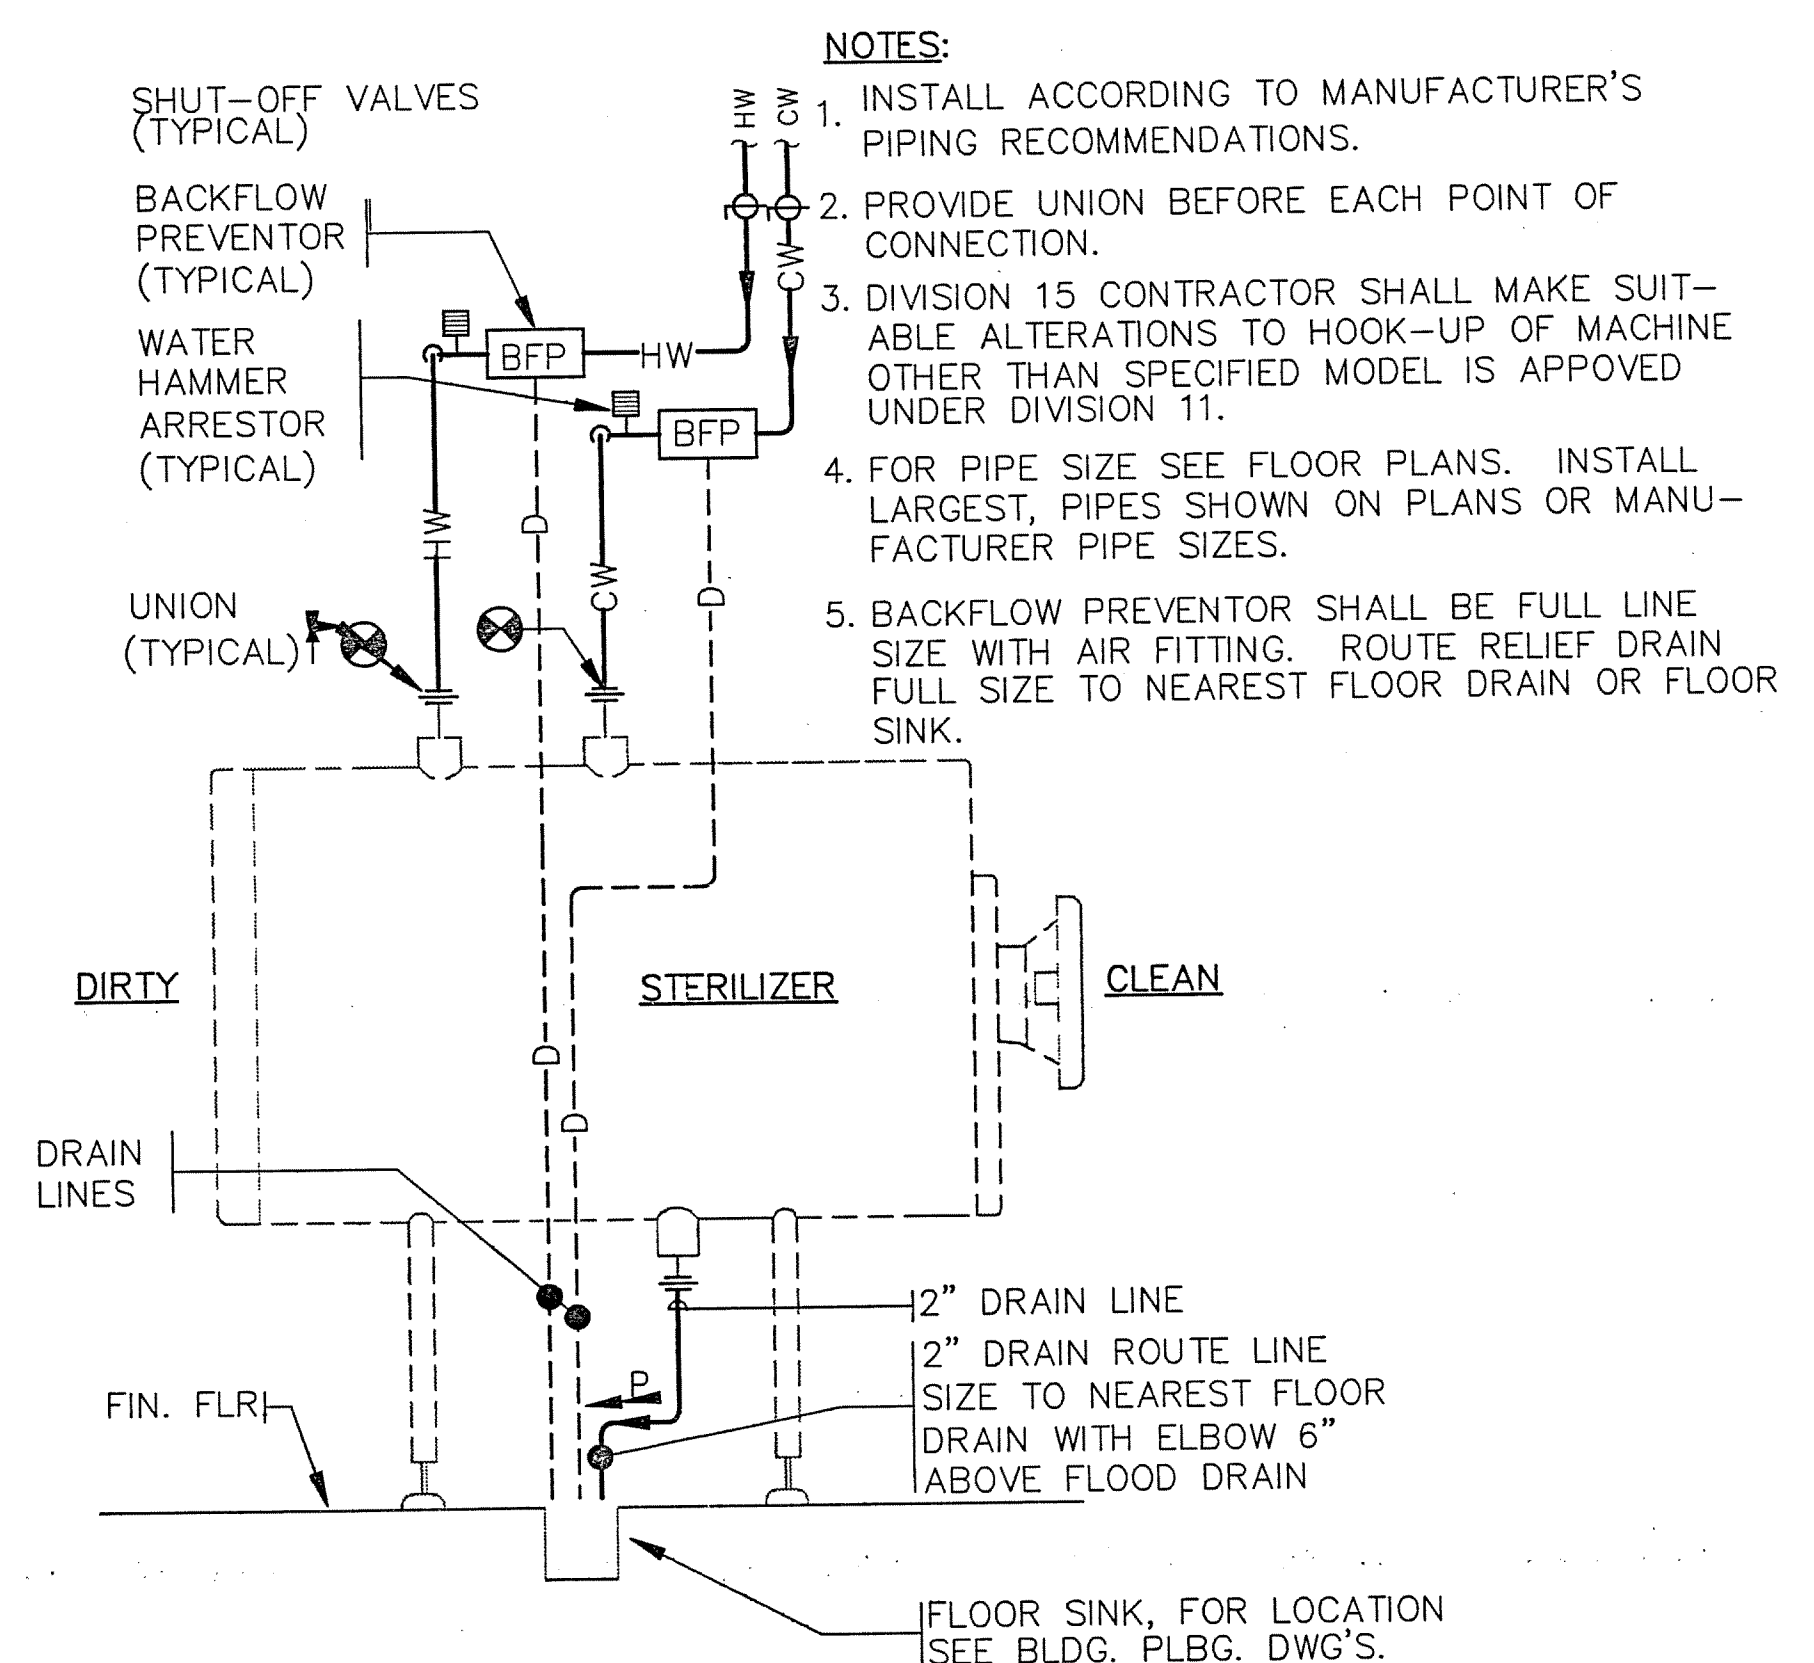

6 STERILIZER PIPING SCHEMATIC  
NOT TO SCALE

EARL WALLS ASSOCIATES © 1994




SCIENCE BUILDING  
UNIVERSITY OF NORTH CAROLINA AT WILMINGTON  
CODE 49888 ITEM 301 ID#6089280301A

SHEET TITLE:

LAB PLUMBING  
DETAILS

AS BUILT

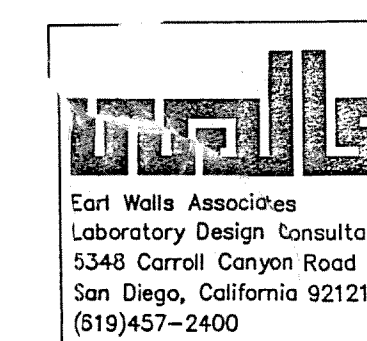

DRAWING REVISIONS:		
NO.	DATE	REMARKS

DATE:	5/16/94
PROJECT#:	8962
DESIGNED BY:	AMA
DRAWN BY:	AMA
CHECKED BY:	ARW

SHEET NO.:

LP14