

JEFFERIES AND FARIS
ASSOCIATES
ARCHITECTS • PLANNERS
SEA TOWERS, SUITE 201
2002 EASTWOOD ROAD
WILMINGTON, N.C. 28403
TEL: 910.256.6633
FAX: 910.256.9088



SCIENCE BUILDING
UNIVERSITY OF NORTH CAROLINA AT WILMINGTON
CODE 49388 ITEM 301 ID#6084280301A

SHEET TITLE:


FIRST FLOOR PLAN - AREA FIVE
EAST

SHEET NO.:

LP5

SERVICE FITTING SCHEDULE

EXAMPLE:
G-1A INDICATES TYPE OF FITTING ABBREVIATED INDIVIDUALLY ON FLOOR PLANS.
LA-10- NUMERICAL REFERENCE OF FITTING ELEV. A = 7" IF B = 21" OR LESS
SEE DRAWING LP-16 A = 9" IF B > 21"

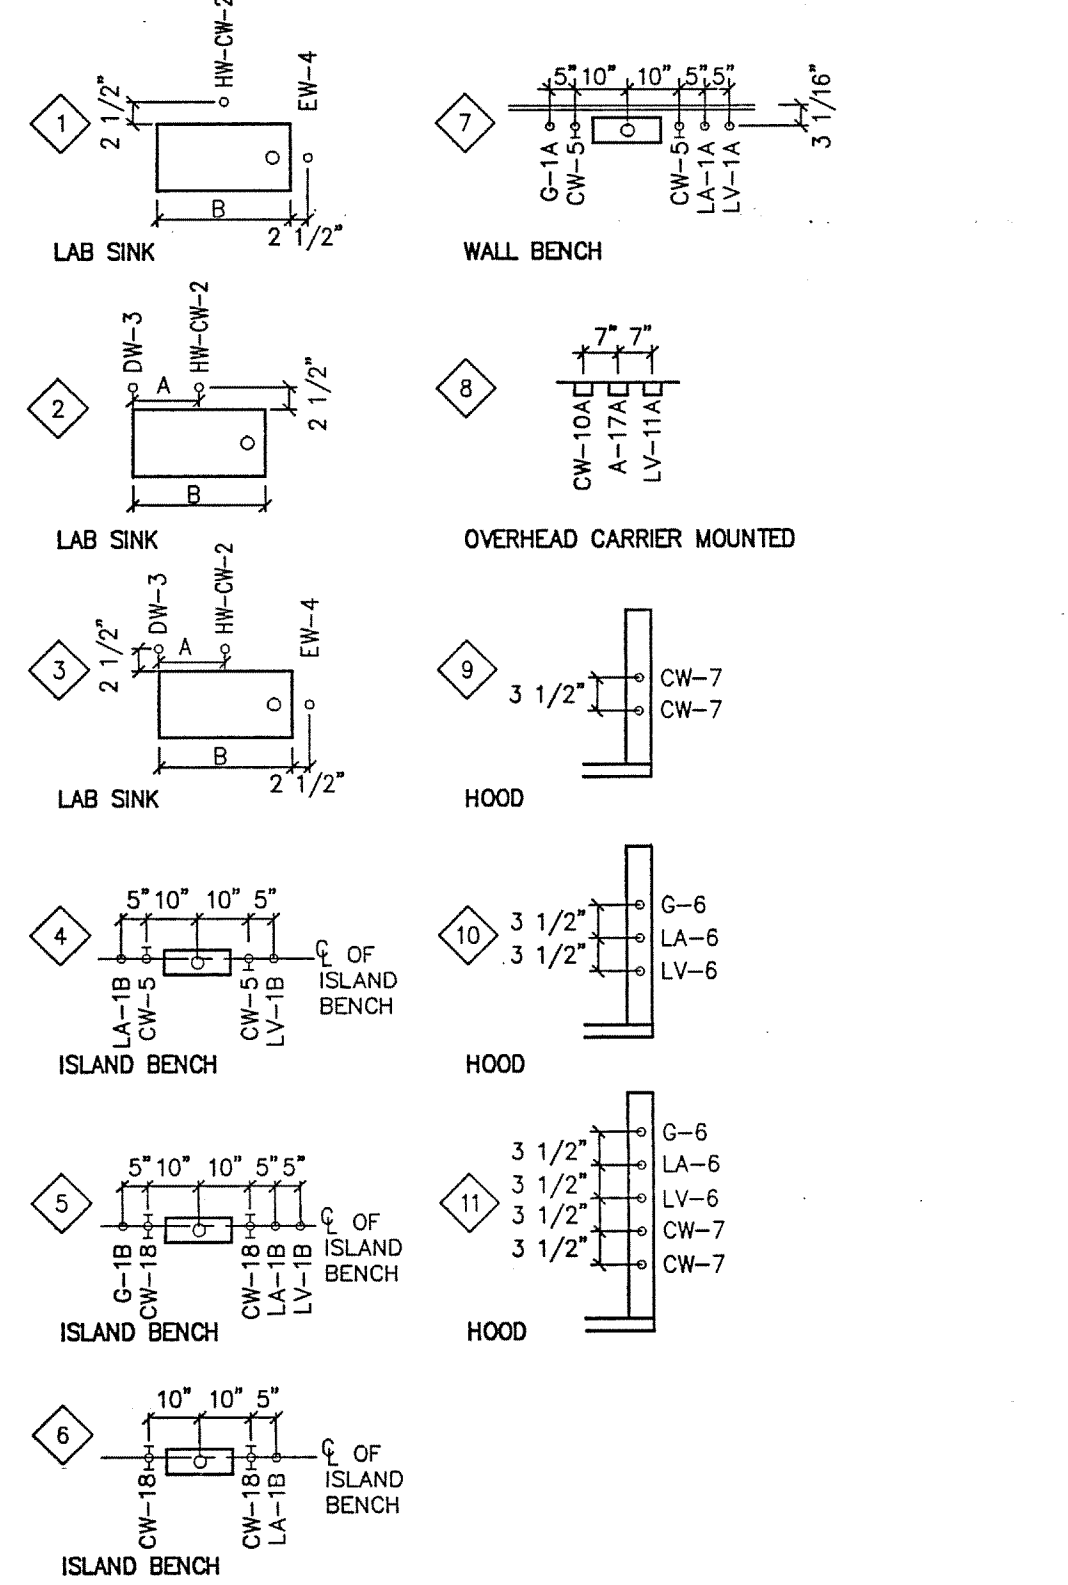

FIRST FLOOR
SCALE: 1/4" = 1'-0"

AREA FIVE
AS BUILT

DRAWING REVISIONS:		
NO.	DATE:	REMARKS:

DATE: 5/16/84
PROJECT#: 8962
DESIGNED BY: AMA
DRAWN BY: AMA
CHECKED BY: ARW

WALLS
Earl Walls Associates
Laboratory Design Consultants
5348 Carroll Canyon Road
San Diego, California 92121
(619)457-2400

MATCH LINE SEE
DWG. LP-0-

MATCH LINE SEE DWG. LP-0-

