


JEFFERIES AND FARIS
ASSOCIATES
ARCHITECTS • PLANNERS
SEA TOWERS, SUITE 201
2002 EASTWOOD ROAD
WILMINGTON, N.C. 28403
TEL: 910.256.6633
FAX: 910.256.9088

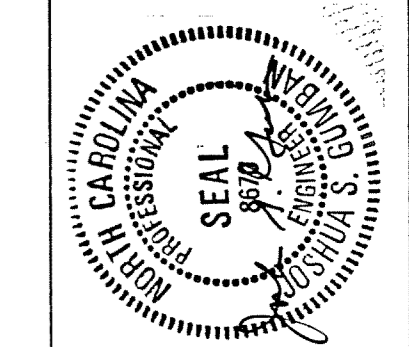


SCIENCE BUILDING
UNIVERSITY OF NORTH CAROLINA AT WILMINGTON
CODE 49888 ITEM 301 ID#6084280301A

SHEET TITLE:

SECOND FLOOR PLAN - AREA FOUR
EAST

AREA FOUR
AS BUILT


SHEET NO.:
LP9

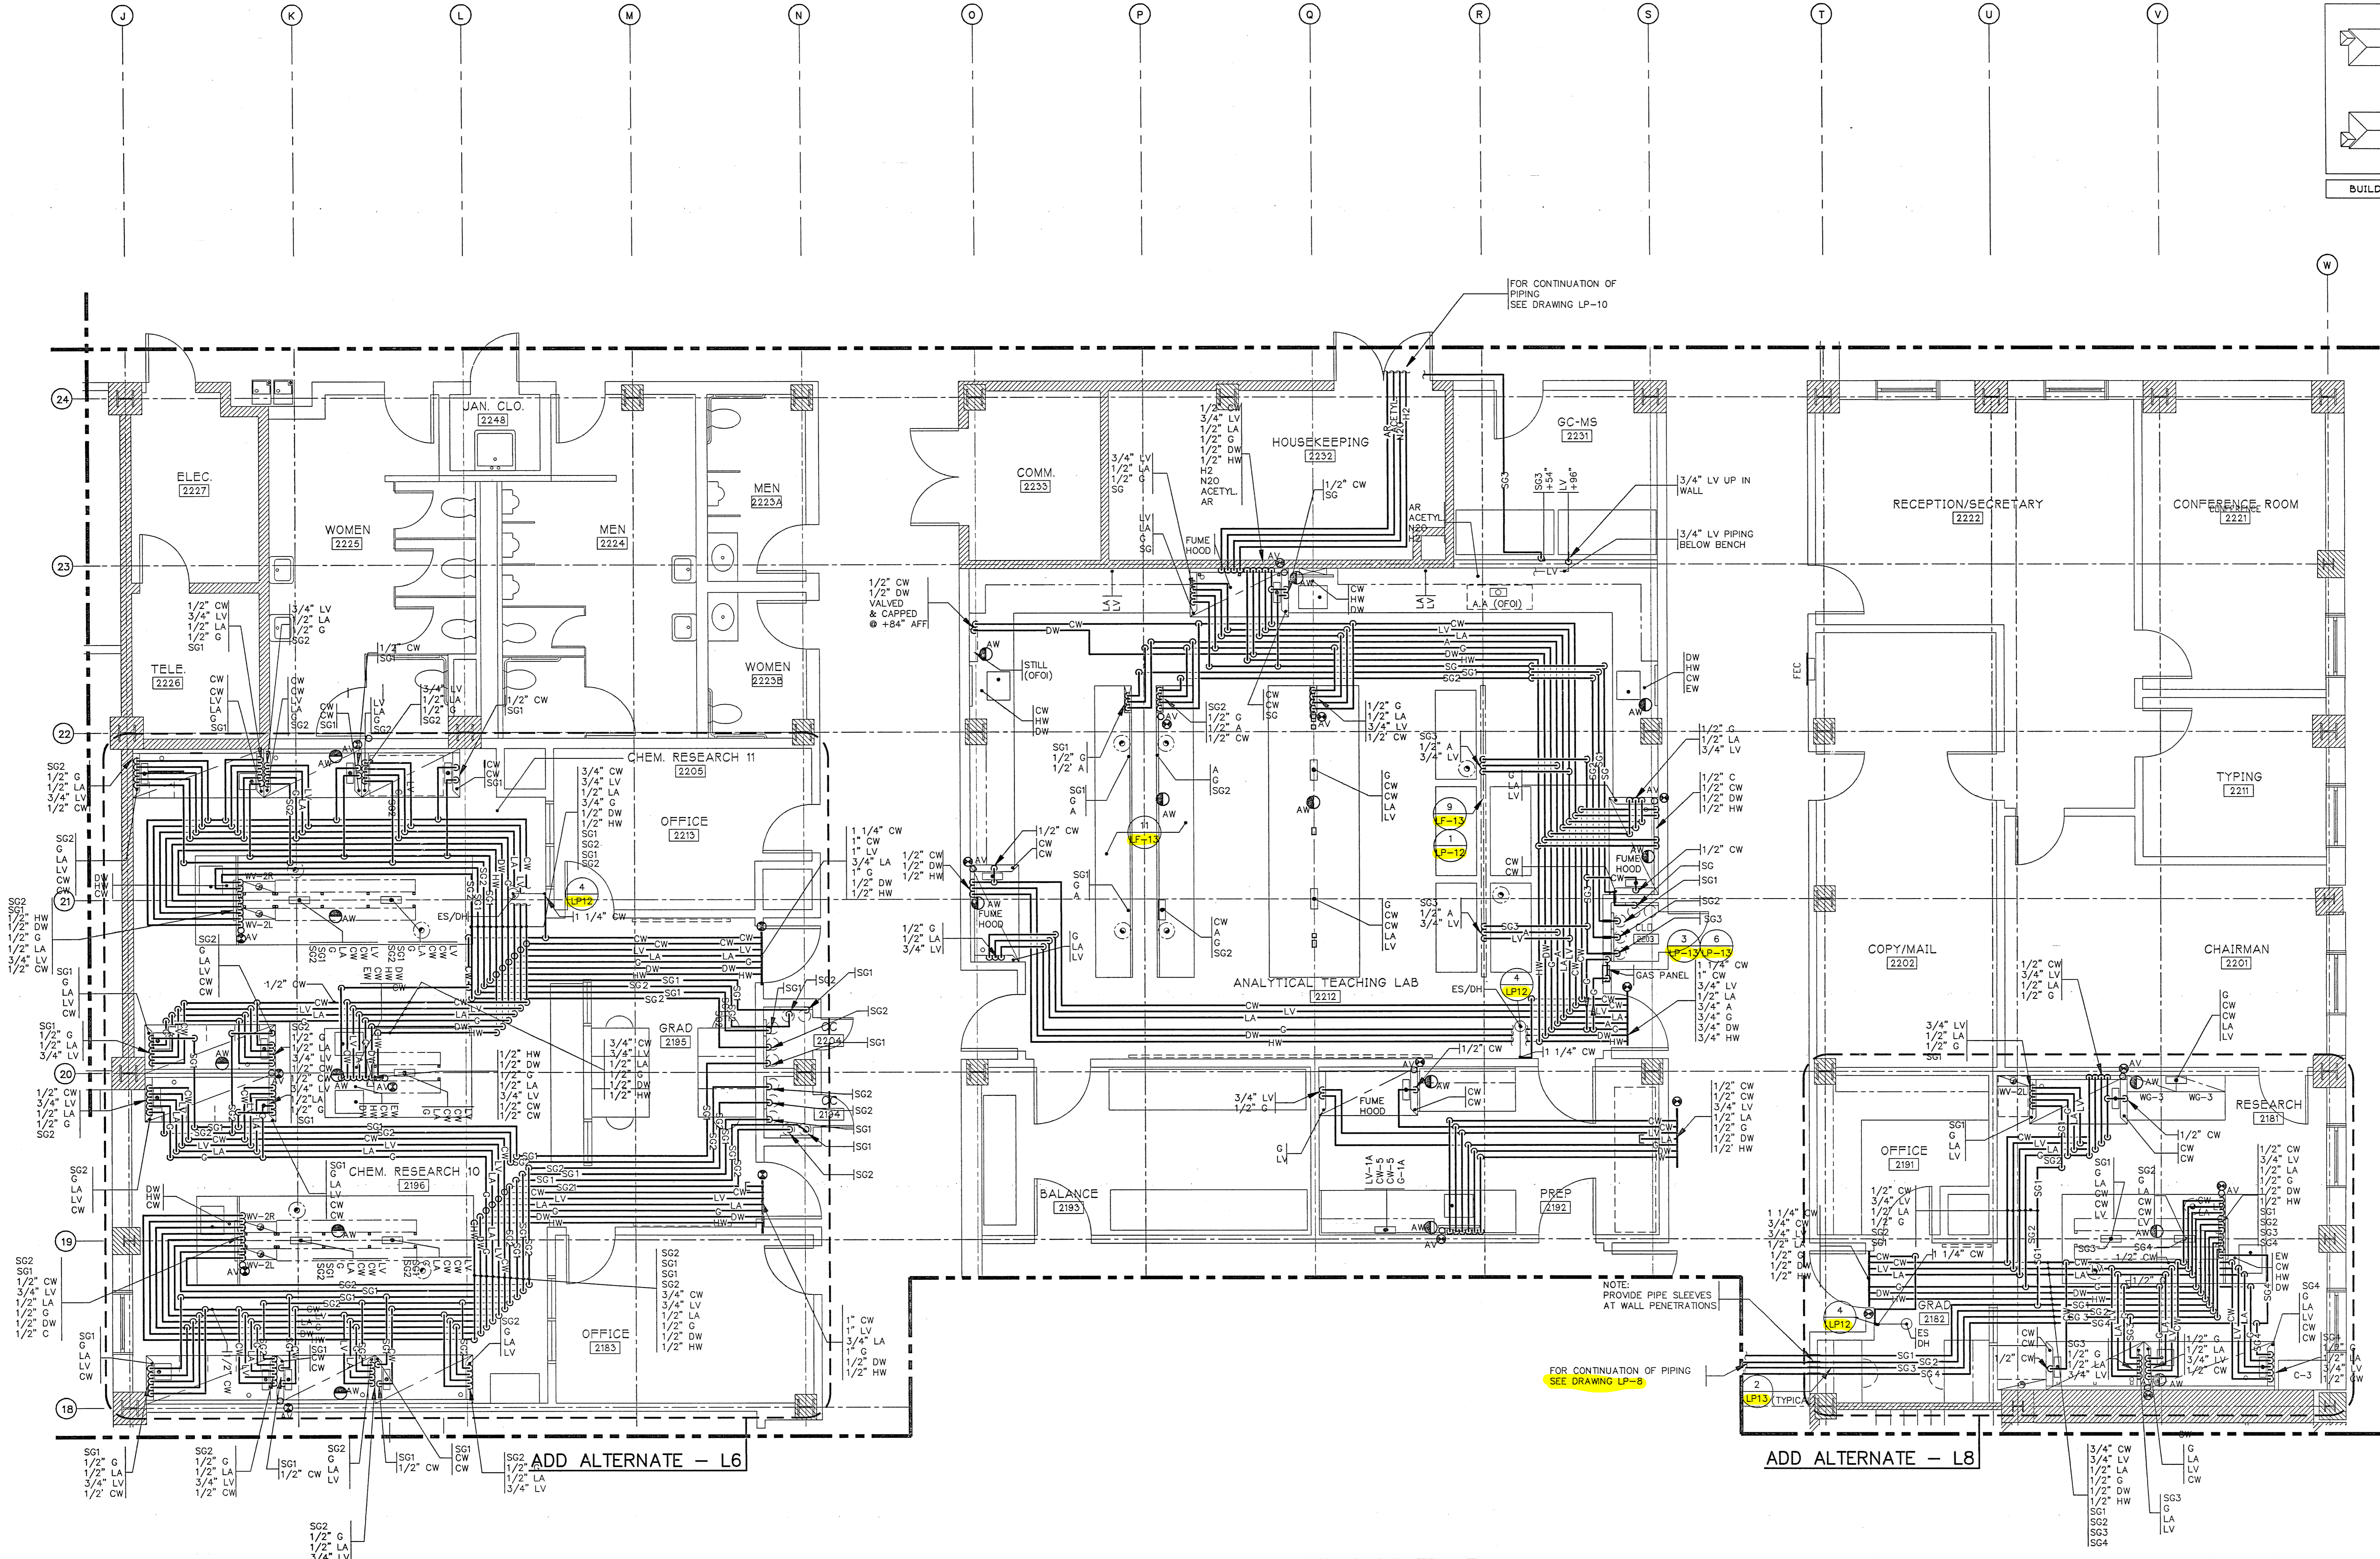

SERVICE FITTING SCHEDULE

EXAMPLE:
G-1A "INDICATES TYPE OF FITTING ABBREVIATED INDIVIDUALLY ON FLOOR PLANS."
LA-1C "NUMERICAL REFERENCE OF FITTING ELEV."
SEE DRAWING LP-16.

FITTINGS MAY ALSO BE INDICATED INDIVIDUALLY ON FLOOR PLANS:
A = 3" IF B = 21" OR LESS
A = 9" IF B > 21"

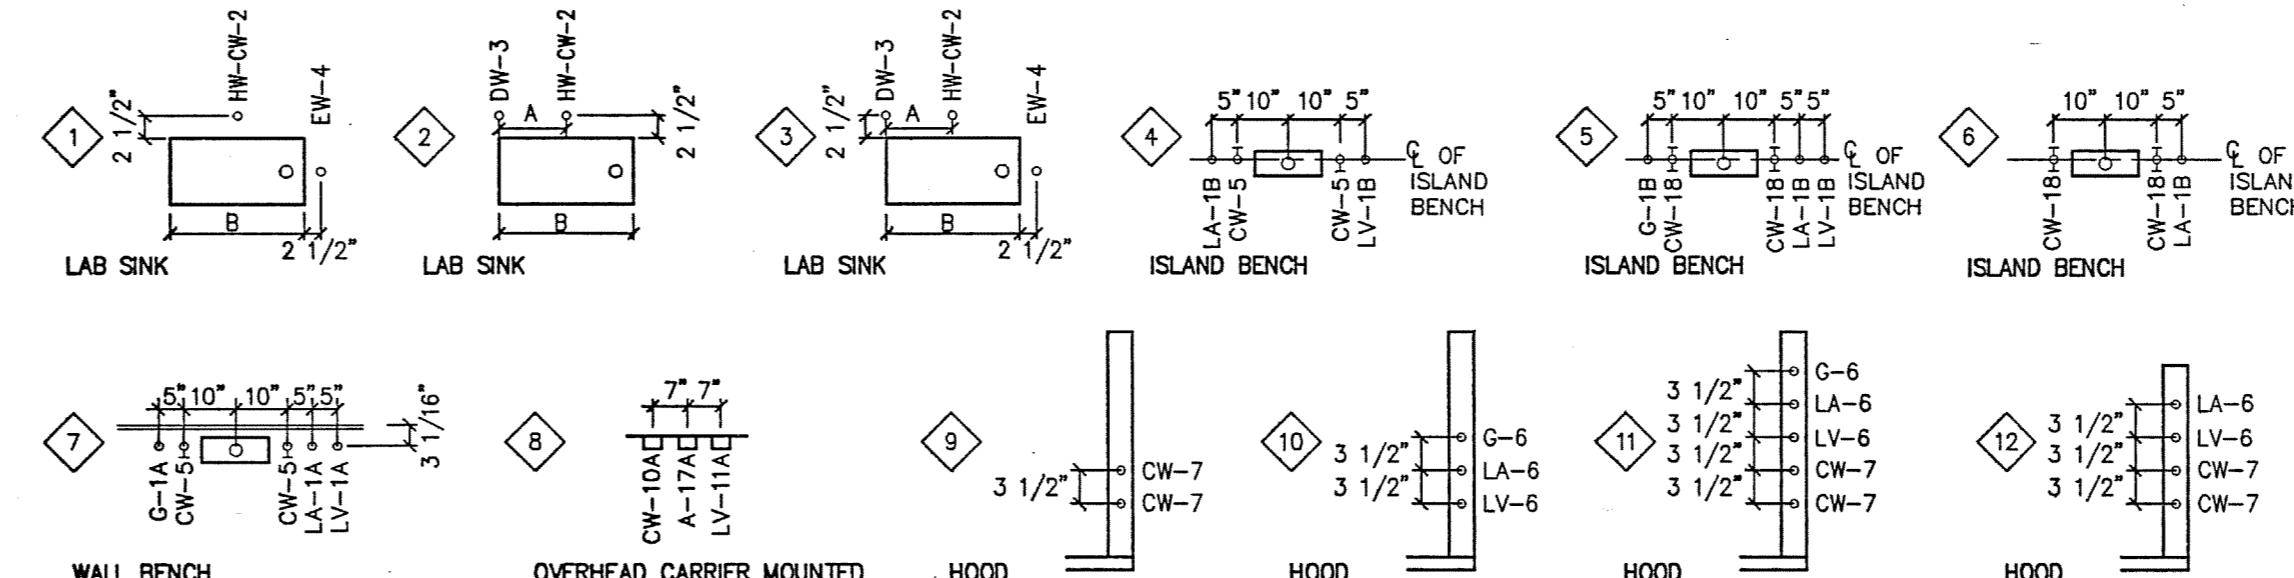

SECOND FLOOR
SCALE: 1/4" = 1'-0"

DRAWING REVISIONS		
NO.	DATE	REMARKS

DATE: 5/16/94
PROJECT#: 8962
DESIGNED BY: AMA
DRAWN BY: AMA
CHECKED BY: ARW

unwall
Ert Wall Associates
Laboratory Design Consultants
5348 Carroll Canyon Road
San Diego, California 92121
(619)457-2400