
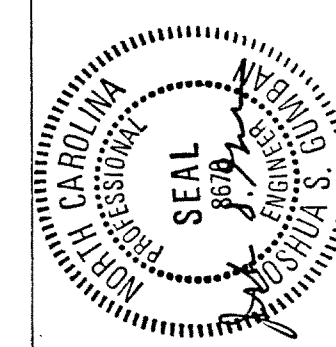


# REFERENCE NOTES:

1. ALL RECEPTACLES, TELCO/DATA AND TV OUTLETS IN OFFICES SHALL BE AT +18".
2. EITHER OF THE 2 EMERG. OFF PUSHBUTTON STATIONS SHALL DE-ENERGIZE PANEL 2LPB.
3. SEAL CONDUIT ENTERING COLD ROOM. COORDINATE POINT OF ENTRY.
4. J.BOX OUTSIDE AND ABOVE COLD ROOM ENCLOSURE, FOR EXTENSION TO CONTROL PANEL BY COLD ROOM MANUFACTURER. COORDINATE LOCATION.
5. +18", MAKE CONNECTIONS TO VACUUM PUMP RECEPTACLE. SEE LAB FURNISHING DRAWINGS.
6. 3/4"C, 2 #12, 2 #10 AND 1 #10 GROUND.
7. 1-1/4"C, 3 #2 AND 1 #8 GROUND.
8. CONNECT TO STERILIZER.
9. CONNECT TO STERILIZER CONTROLS.
10. LOCATE INSIDE UMBILICAL.
11. 3/4"C, 3 #12, 3 #10 AND 1 #10 GROUND.
12. EMERGENCY OFF PUSHBUTTON STATION SHALL DE-ENERGIZE BOTH PANELS 2LPD AND 2LPE.
13. TO PANEL 2LPE SHUNT-TRIP MAIN BREAKER.

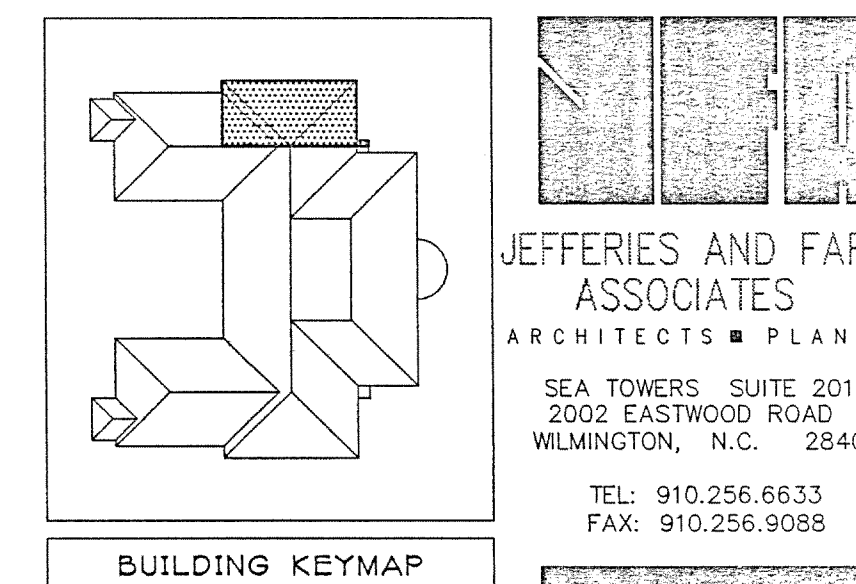

SCIENCE BUILDING  
UNIVERSITY OF NORTH CAROLINA AT WILMINGTON  
CODE 44888 ITEM 301 ID#6084280301A

SECOND FLOOR  
SCALE: 1/4" = 1'-0"

AREA FIVE  
AS BUILT

**unil**  
Earl Wata Associates  
Laboratory Design Consultants  
5348 Carroll Canyon Road  
San Diego, California 92121  
(619)457-2400

DRAWING REVISIONS:		
NO.	DATE	REMARKS

DATE: 5/16/94  
PROJECT#: 8962  
DESIGNED BY: JSG  
DRAWN BY: GRM  
CHECKED BY: JSG

SHEET NO.:  
**LE10**