
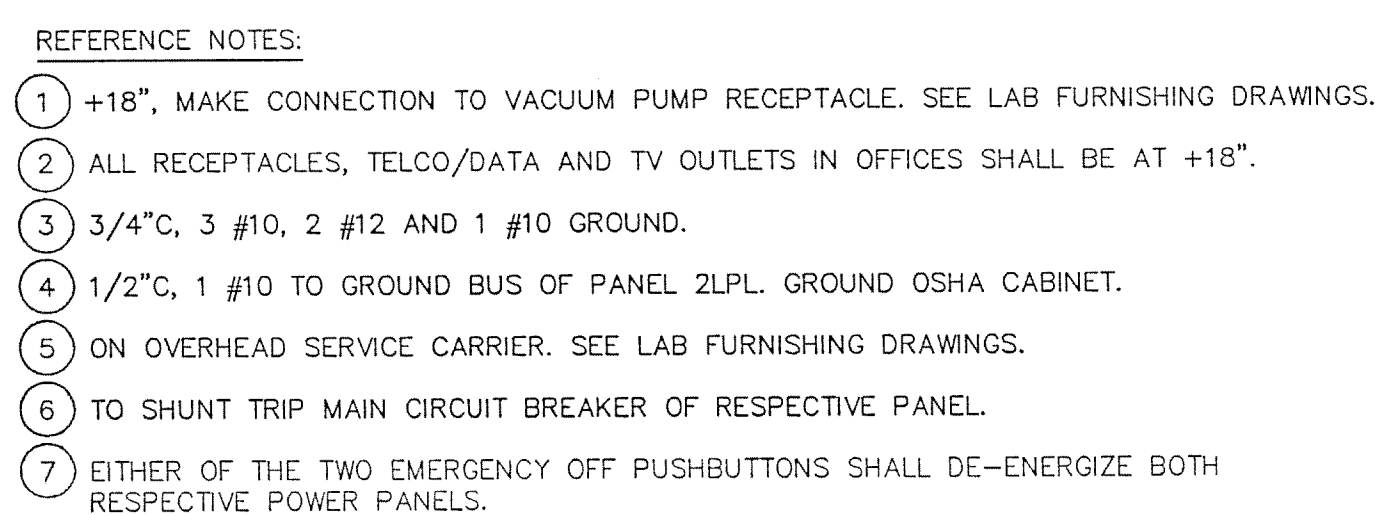


SHEET TITLE:



SHEET NO.:

LE9




ADD ALTERNATE - L8

AREA FOUR
AS BUILT

[illegible]

DATE: 5/16/94
PROJECT#: 8962
DESIGNED BY: JSG
DRAWN BY: GRM
CHECKED BY: JSG
CHECKED BY:



Earl Walls Associates
Laboratory Design Consultants
5348 Carroll Canyon Road
San Diego, California 92121
(619)457-2400