

FINISH SCHEDULE

PROJECT Dobo Hall Lab Renovation


SHEET: 1 of 1
DATE: 1/26/2017
PROJECT NO: 2012168.01

SPACE		FLOOR	BASE	WALLS								CEILING			REMARKS
NO.	NAME			NORTH		EAST		SOUTH		WEST		MAT	FIN	HT	
				MAT	FIN	MAT	FIN	MAT	FIN	MAT	FIN				
117	LAB	VINYL	ICB	CMU	PT-1	CMU	PT-1	CMU	PT-1	CMU/GWB	PT-1	ACT	NA	10'-0"	
117A	PREP ROOM	VINYL	ICB	CMU	PT-1	CMU	PT-1	CMU	PT-1	CMU	PT-1	ACT	NA	10'-0"	
117B	OFFICE	CARPET	VWB	CMU	PT-1	GWB	PT-1	GWB	PT-1	CMU	PT-1	ACT	NA	10'-0"	
119	LAB	VINYL	ICB	CMU	PT-1	CMU	PT-1	CMU	PT-1	CMU/GWB	PT-1	ACT	NA	10'-0"	
119A	PREP ROOM	VINYL	ICB	CMU	PT-1	GWB	PT-1	CMU	PT-1	CMU	PT-1	ACT	NA	10'-0"	
119B	GRAD STUDENT OFFICE	CARPET	VWB	CMU	PT-1	CMU	PT-1	CMU	PT-1	GWB	PT-1	ACT	NA	10'-0"	
119C	FACULTY OFFICE	VINYL	ICB	CMU/GWB	PT-1	GWB	PT-1	CMU	PT-1	CMU	PT-1	ACT	NA	10'-0"	


NOTE: ALL COLORS AND FINISHES TO BE SELECTED BY UNCW.

LEGEND

ICB	INTEGRAL COVE BASE
VWB	VINYL WALL BASE
GWB	GYPSUM WALL BOARD
CMU	CONCRETE MASONRY UNIT
PT-1	PAINT
EPT	EPOXY PAINT
ACT	ACOUSTICAL CEILING TILE
EX	EXISTING
N/A	NOT APPLICABLE

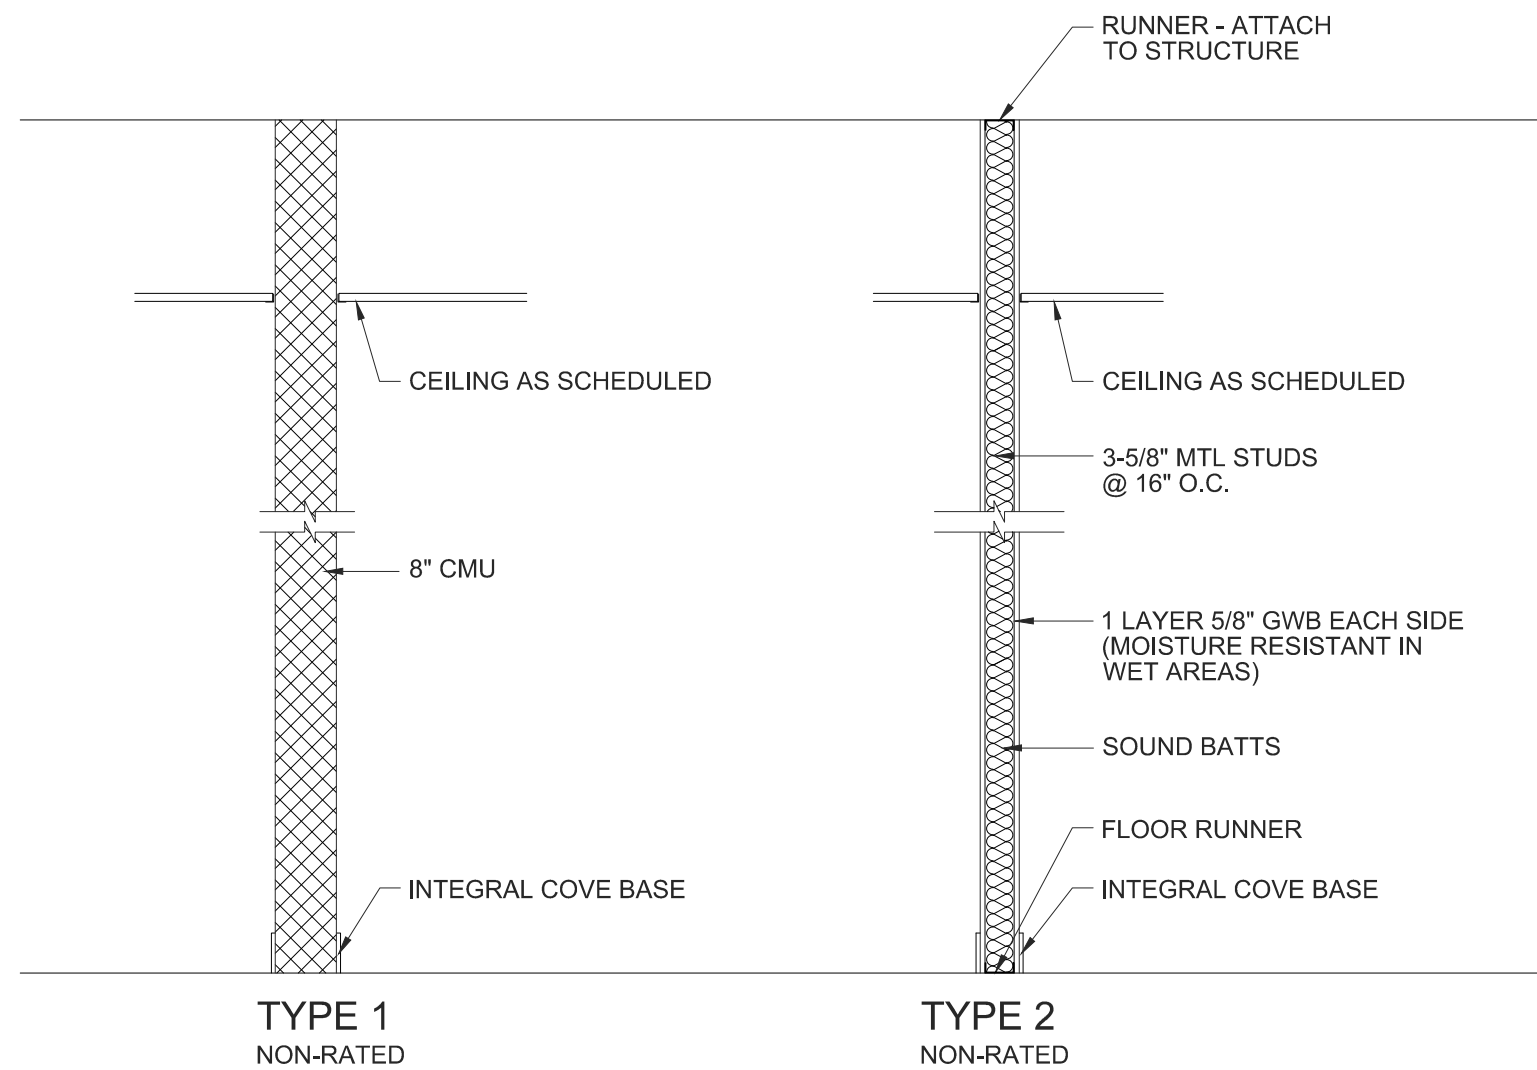

1 WALL TYPES
SCALE: 1/2" = 1'-0"

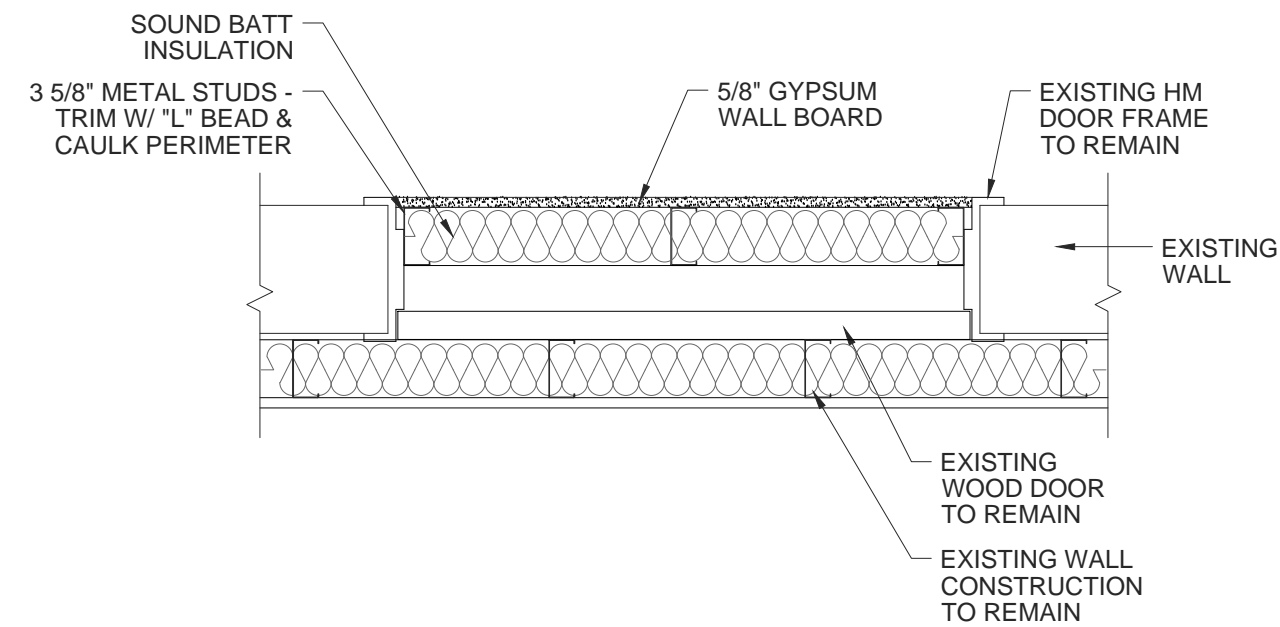

4 DOOR INFILL DETAIL
SCALE: 1" = 1'-0"

DOOR SCHEDULE

PROJECT DOBO HALL LABORATORY RENOVATION

SHEET: 1 of 1
DATE: 05/05/2016
PROJECT NO: 2012168.01


DOOR #	DOOR		FRAME								HARDWARE		REMARKS		
	SIZE	HEIGHT	MAT	TYPE	FIN	GLASS	MAT	TYPE	FIN	DETAILS		RATING		SET NO.	KEY
										JAMB	HEAD				
117B	3'-0"	7'-0"	WOOD	1	STAIN	N/A	HM	A	PAINT	J1	H1	1			
119A	3'-0"	7'-0"	WOOD	1	STAIN	N/A	HM	B	PAINT	J2	H2	2			
119B	3'-0"	7'-0"	WOOD	1	STAIN	N/A	HM	B	PAINT	J2	H2	2			
119C	3'-0"	7'-0"	WOOD	1	STAIN	N/A	HM	A	PAINT	J1	H1	2			

HARDWARE SCHEDULE



PROJECT DOBO HALL LABORATORY RENOVATION

SHEET: 1 of 1
DATE: 1/26/2017
PROJECT NO: 2012168.01



OPG. NO.	MK	NAME	LOCKSET TYPE										SET NO.						
			ENTRY	CYLINDER	OFFICE	PASSAGE	PRIVACY	PADDLE	EXIT DEVICE	PUSH/PULL	CLOSER	HINGES		BB HINGES	PIVOTS	WALL STOP	KICK PLATE	THRESHOLD/ WITH STRIP	FLUSH BOLTS
117	B	OFFICE - LAB			X							X							1
119	A	PREP - LAB			X							X		X					2
119	B	GSA - LAB			X							X		X					2
119	C	OFFICE - LAB			X							X		X					2

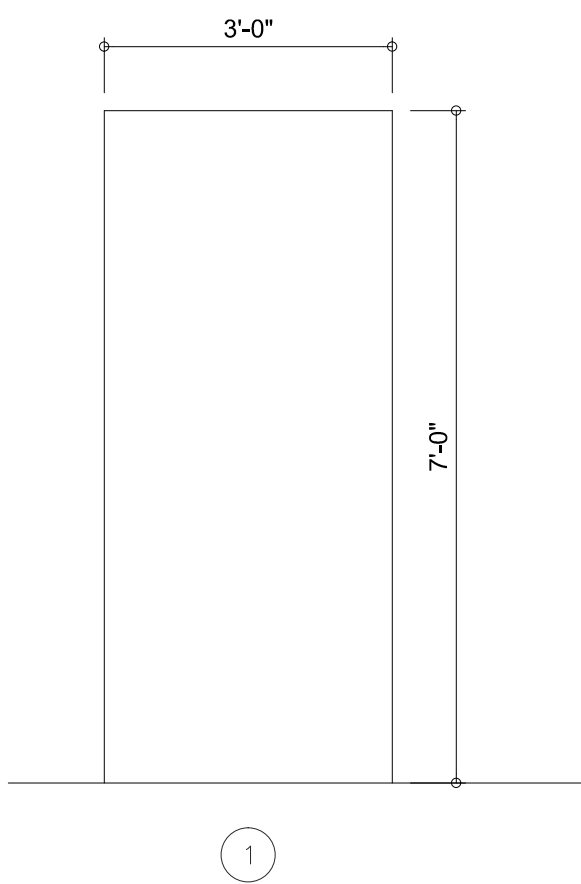



2 DOOR / FRAME TYPES
SCALE: 1/2" = 1'-0"

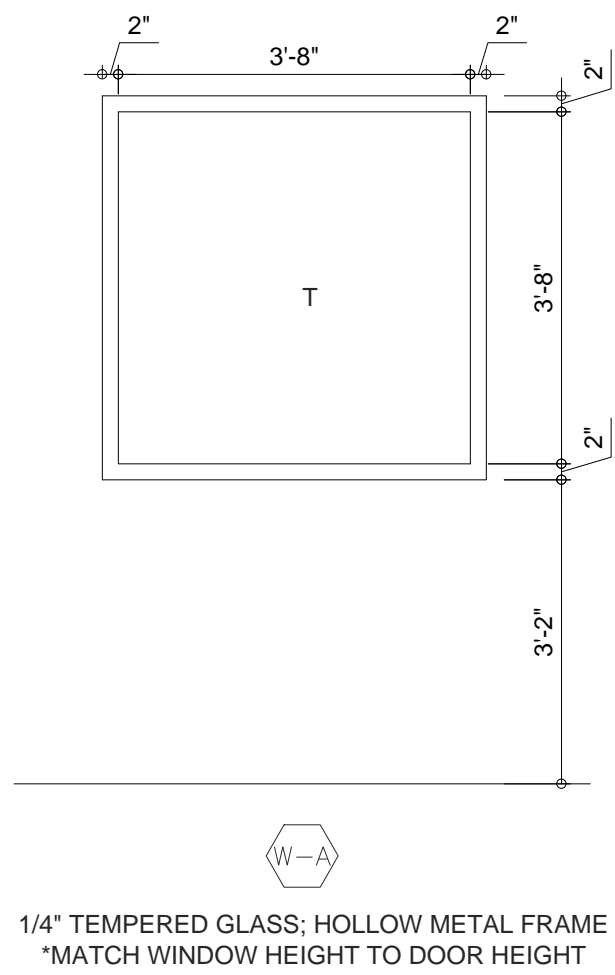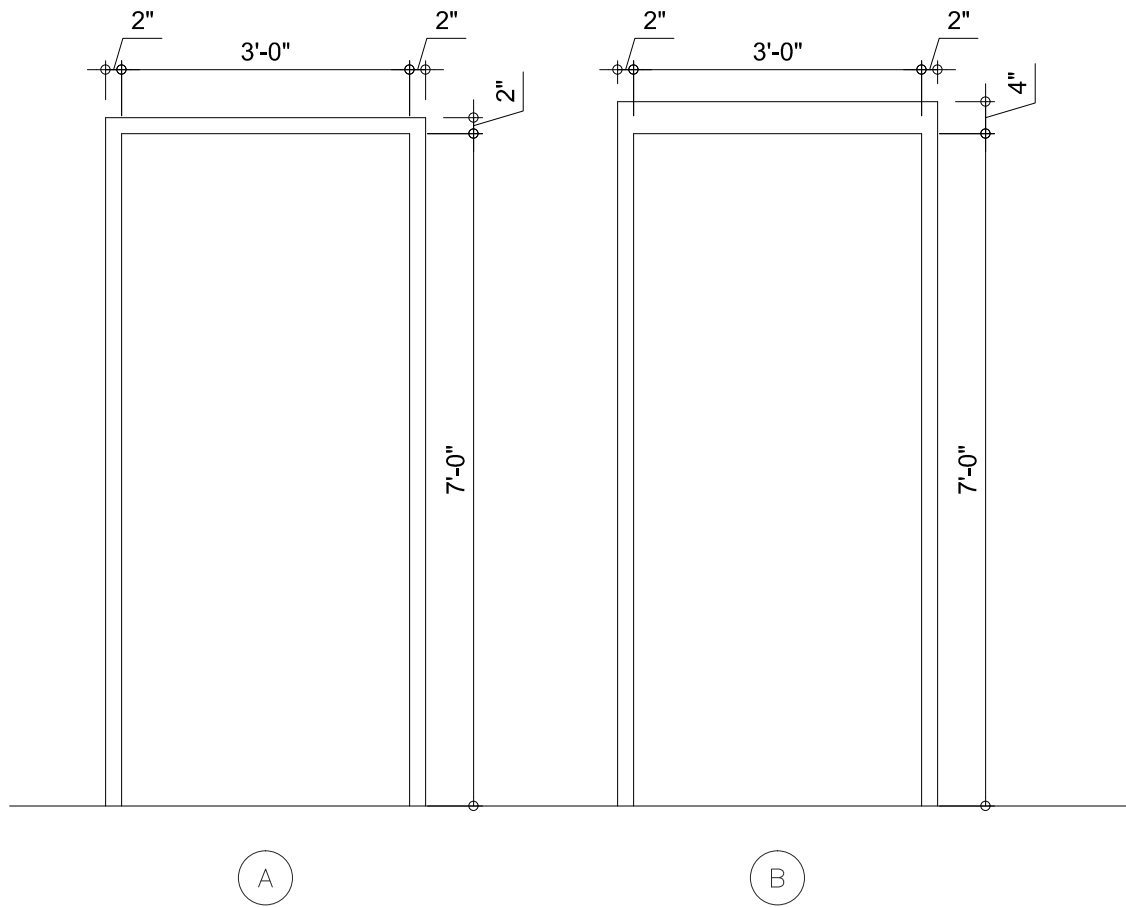

3 WINDOW / FRAME TYPE
SCALE: 1/2" = 1'-0"

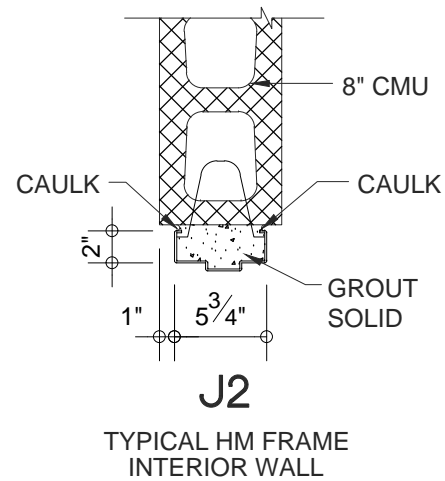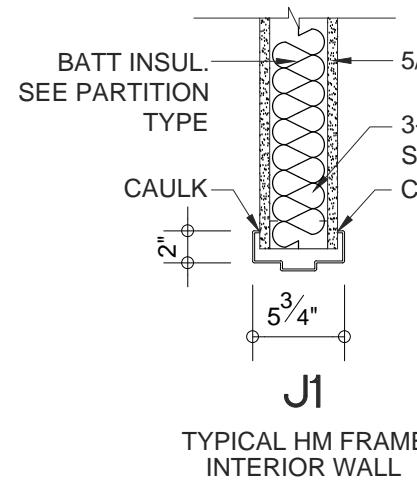

5 JAMB DETAILS
SCALE: 1" = 1'-0"

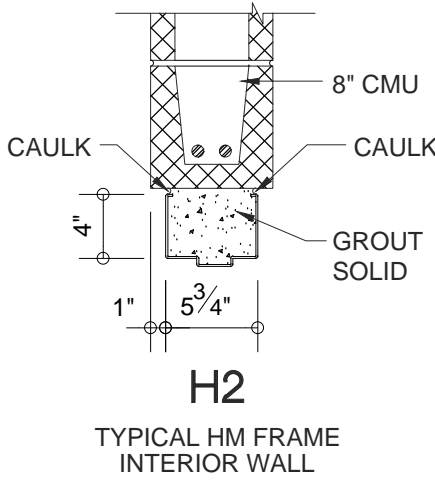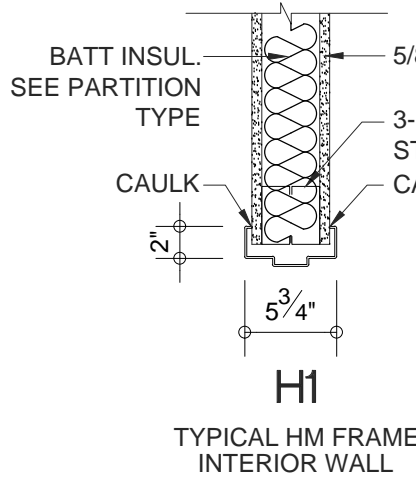

6 HEAD DETAILS
SCALE: 1" = 1'-0"

BECKER
MORGAN
GROUP

ARCHITECTURE
PLANNING

Wilmington, NC
3205 Randall Parkway, Suite 211
Wilmington, NC 28403
910.341.7600
Salisbury, MD
312 West Main St. Suite 300
Salisbury, MD 21801
410.546.9100
Dover, DE
309 S Governors Ave
Dover, DE 19904
302.734.7950
www.beckermorgan.com

RECORD DRAWINGS

THIS DOCUMENT
REFLECTS CHANGES TO
THE DESIGN DOCUMENTS
MADE DURING
CONSTRUCTION BY THE
CONTRACTOR AND
SUBMITTED TO THE
ARCHITECT AFTER
CONSTRUCTION. FIELD
VERIFICATION BY THE
ARCHITECT WAS NOT
PROVIDED.

PROJECT TITLE



Dobo Hall Labs
117 & 119
Renovations

601 S College Rd.
Wilmington, NC 28403

STATE ID #: 17-16975-01A

SHEET TITLE

DETAILS &
SCHEDULES

ISSUE BLOCK

10/13/2017 RECORD DRAWINGS

MARK DATE DESCRIPTION
PROJECT NO: 2012168.01
DATE: 04/07/2017
SCALE:
DRAWN BY: NMY PROJ MGR: EWO

A601
COPYRIGHT © 2017