

# Dobo Hall


# Labs 117 and 119 Renovations

FOR

## UNCW

1123 Walton Drive  
Wilmington, NC 28403  
STATE ID#: 17-16975-01A



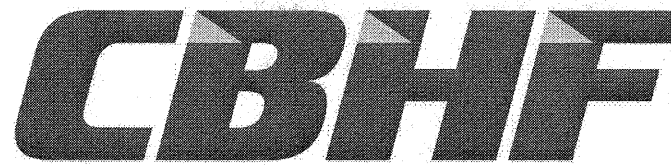


**Engineers, PLLC**

2246 Yaupon Drive  
Wilmington, NC 28401

Phone: 910.791.4000  
Fax: 910.791.5266  
www.cbhfengineers.com  
NC# P-0506

© Copyright 2017 CBHF Engineers, PLLC

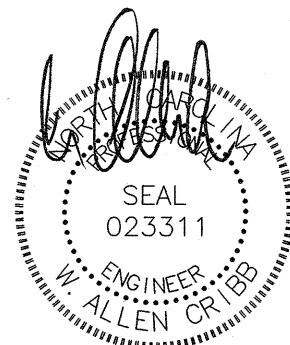

### DRAWING INDEX

**GENERAL**  
COVER SHEET

**ARCHITECTURAL**

- G001 COVER AND DRAWING INDEX
- G002 BUILDING CODE SUMMARY LIFE SAFETY PLAN
- AD101 DEMOLITION PLAN
- A101 FLOOR PLAN
- A102 REFLECTED CEILING PLAN
- A601 DETAILS & SCHEDULES

**PLUMBING**

- P0.1 PLUMBING LEGEND, GENERAL NOTES AND DETAIL
- PD1.1 PLUMBING PIPING DEMOLITION PLANS
- P1.1 PLUMBING PIPING PLANS

**MECHANICAL**

- M0.1 MECHANICAL GENERAL NOTES, SCHEDULES AND LEGEND
- M0.2 MECHANICAL DETAILS
- M0.3 MECHANICAL DETAILS
- MD1.1 MECHANICAL HVAC DEMOLITION PLAN, GENERAL DEMOLITION NOTES AND DEMOLITION KEYED NOTES
- M1.1 MECHANICAL HVAC PLAN
- M1.2 MECHANICAL AIR BALANCE SUMMARY
- M6.1 MECHANICAL CONTROL DIAGRAMS AND SEQUENCE OF OPERATION

**ELECTRICAL**

- E0.1 ELECTRICAL LEGEND, NOTES, ABBREVIATIONS AND DETAIL
- E0.2 ELECTRICAL DETAILS
- E0.3 ELECTRICAL PANEL SCHEDULES
- ED1.1 ELECTRICAL POWER DEMOLITION PLAN
- ED2.1 ELECTRICAL LIGHTING DEMOLITION PLAN
- E1.1 ELECTRICAL POWER PLAN
- E2.1 ELECTRICAL LIGHTING PLAN

**RECORD DRAWING**

These Record Documents have been prepared based on information provided by others. The Engineer has not verified the accuracy and/or completeness of this information and shall not be the responsible for any errors or omissions which may be incorporated herein as a result.

Dated: 2017-10-13  
By: 