


**LEGEND**  
SA - SUPPLY AIR, CFM  
RA - RETURN AIR, CFM  
EA - EXHAUST AIR, CFM  
TA(+) - NET TRANSFER AIR FROM SPACE, CFM  
TA(-) - NET TRANSFER AIR TO SPACE, CFM

**1 - AIR BALANCE PLAN**  
1/4"=1'-0"


**RECORD DRAWING**  
These Record Documents have been prepared based on information provided by others. The Engineer has not verified the accuracy and/or completeness of this information and shall not be the responsible for any errors or omissions which may be incorporated herein as a result.

Dated: 2017-10-13  
By: [Signature]

FIRE RATING LEGEND	
1 HR	1 HOUR RATED FIRE PARTITION

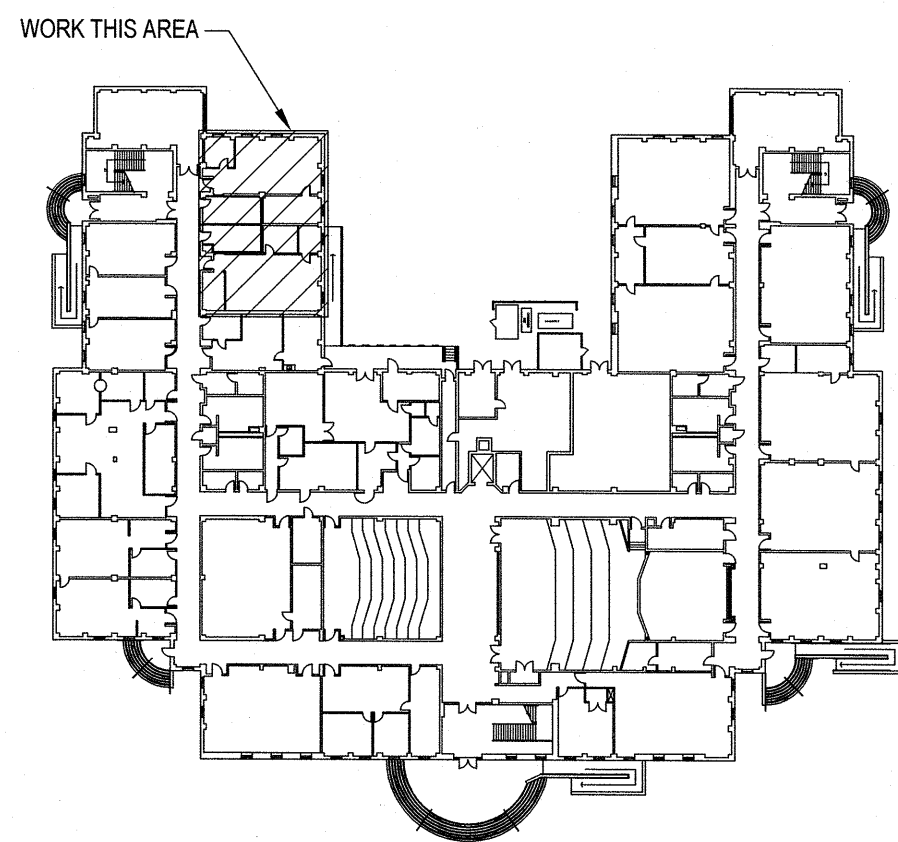

**KEY PLAN**  
NOT TO SCALE

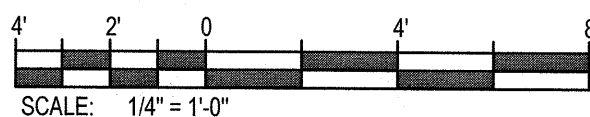

UNIVERSITY OF NORTH CAROLINA WILMINGTON  
DOBO HALL LABS 117 AND 119 RENOVATIONS  
601 S. COLLEGE ROAD, WILMINGTON, NORTH CAROLINA 28403  
STATE ID# 17-16975-01A

MECHANICAL

AIR BALANCE SUMMARY

Job No.: 15250  
Drawn: GRM  
Designed: GRM  
Checked: DMH

Drawing No:  
**M1.2**

Revision:  
**0**

2246 Yaupon Drive  
Wilmington, NC 28401  
© Copyright 2017 CBHF Engineers, PLLC

CBHF

Engineers, PLLC

Phone: 910.791.4000  
Fax: 910.791.5266  
www.cbhfindesign.com  
NCEP-0006

RECORD DRAWINGS  
10.13.17  
Date

REVISIONS