


WASTE-VENT DEMOLITION KEYED NOTES


- EXISTING CLEANOUT IN CRAWL SPACE TO REMAIN.
- EXISTING 4" ACID WASTE STACK TO REMAIN.
- EXISTING 2" ACID VENT STACK TO REMAIN.
- 2" VENT STACK TO REMAIN.
- REMOVE EXISTING ACID WASTE AND VENT PIPING IN CRAWL SPACE AND ABOVE CEILING AS SHOWN BY HATCHING.
- REMOVE EXISTING ACID WASTE PIPING IN CRAWL SPACE AS SHOWN BY HATCHING.
- REMOVE EXISTING WASTE AND VENT PIPING IN CRAWL SPACE AND ABOVE CEILING AS SHOWN BY HATCHING.

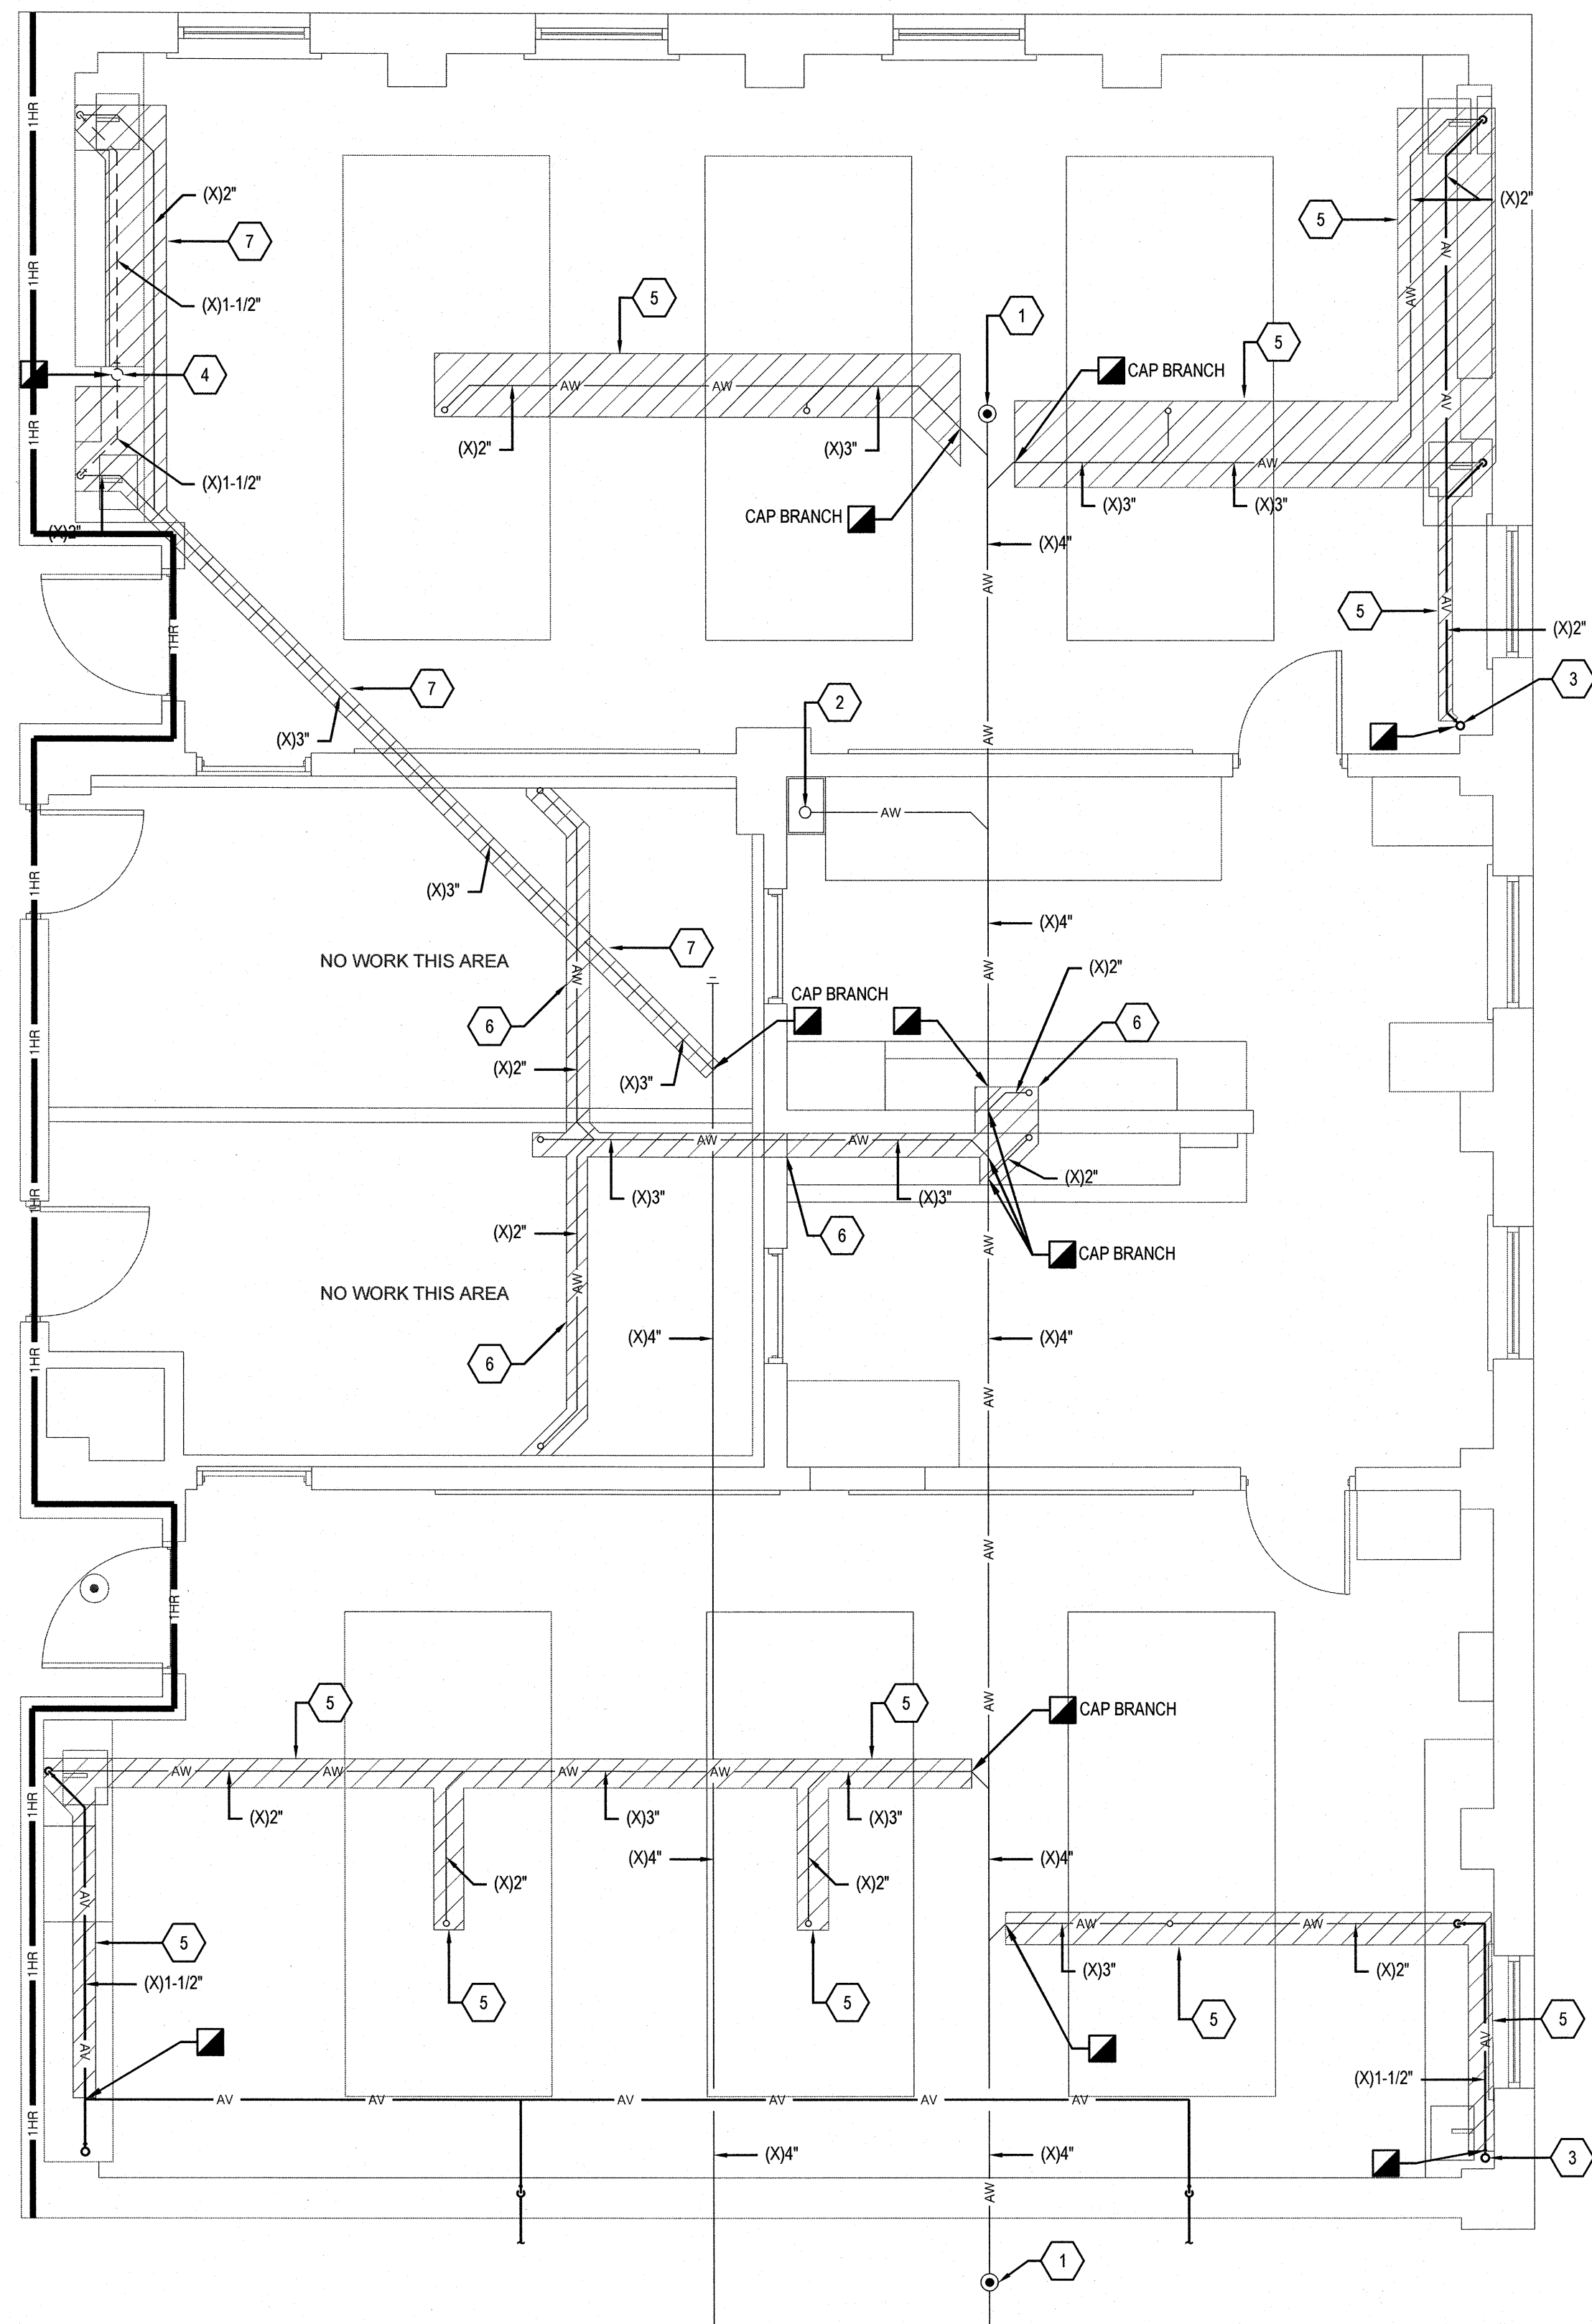

1 - WASTE-VENT DEMOLITION PLAN
1/4" = 1'-0"

LAB GASES DEMOLITION KEYED NOTES

- REMOVE (X) SINK TRIM, AND ASSOCIATED PIPING IN ITS ENTIRETY.
- EXISTING DRENCH SHOWER TO REMAIN.
- REMOVE ALL LAB GAS AND WATER PIPING ABOVE CEILING BACK TO THE MAIN BRANCH VALVE WHERE PIPING ENTERS ROOM OVERHEAD.
- REMOVE DECK MOUNTED AIR, GAS AND VACUUM NEEDLE VALVES AND ITS ASSOCIATED PIPING IN ITS ENTIRETY BACK TO MAIN BRANCH VALVE WHERE PIPING ENTERS ROOM OVERHEAD.
- REMOVE EXISTING LAB GASES AND WATER PIPING FROM EXISTING FUME HOOD IN ITS ENTIRETY BACK TO THE MAIN BRANCH VALVE WHERE PIPING ENTERS ROOM OVERHEAD. HOOD TO BE REMOVED BY OTHERS.

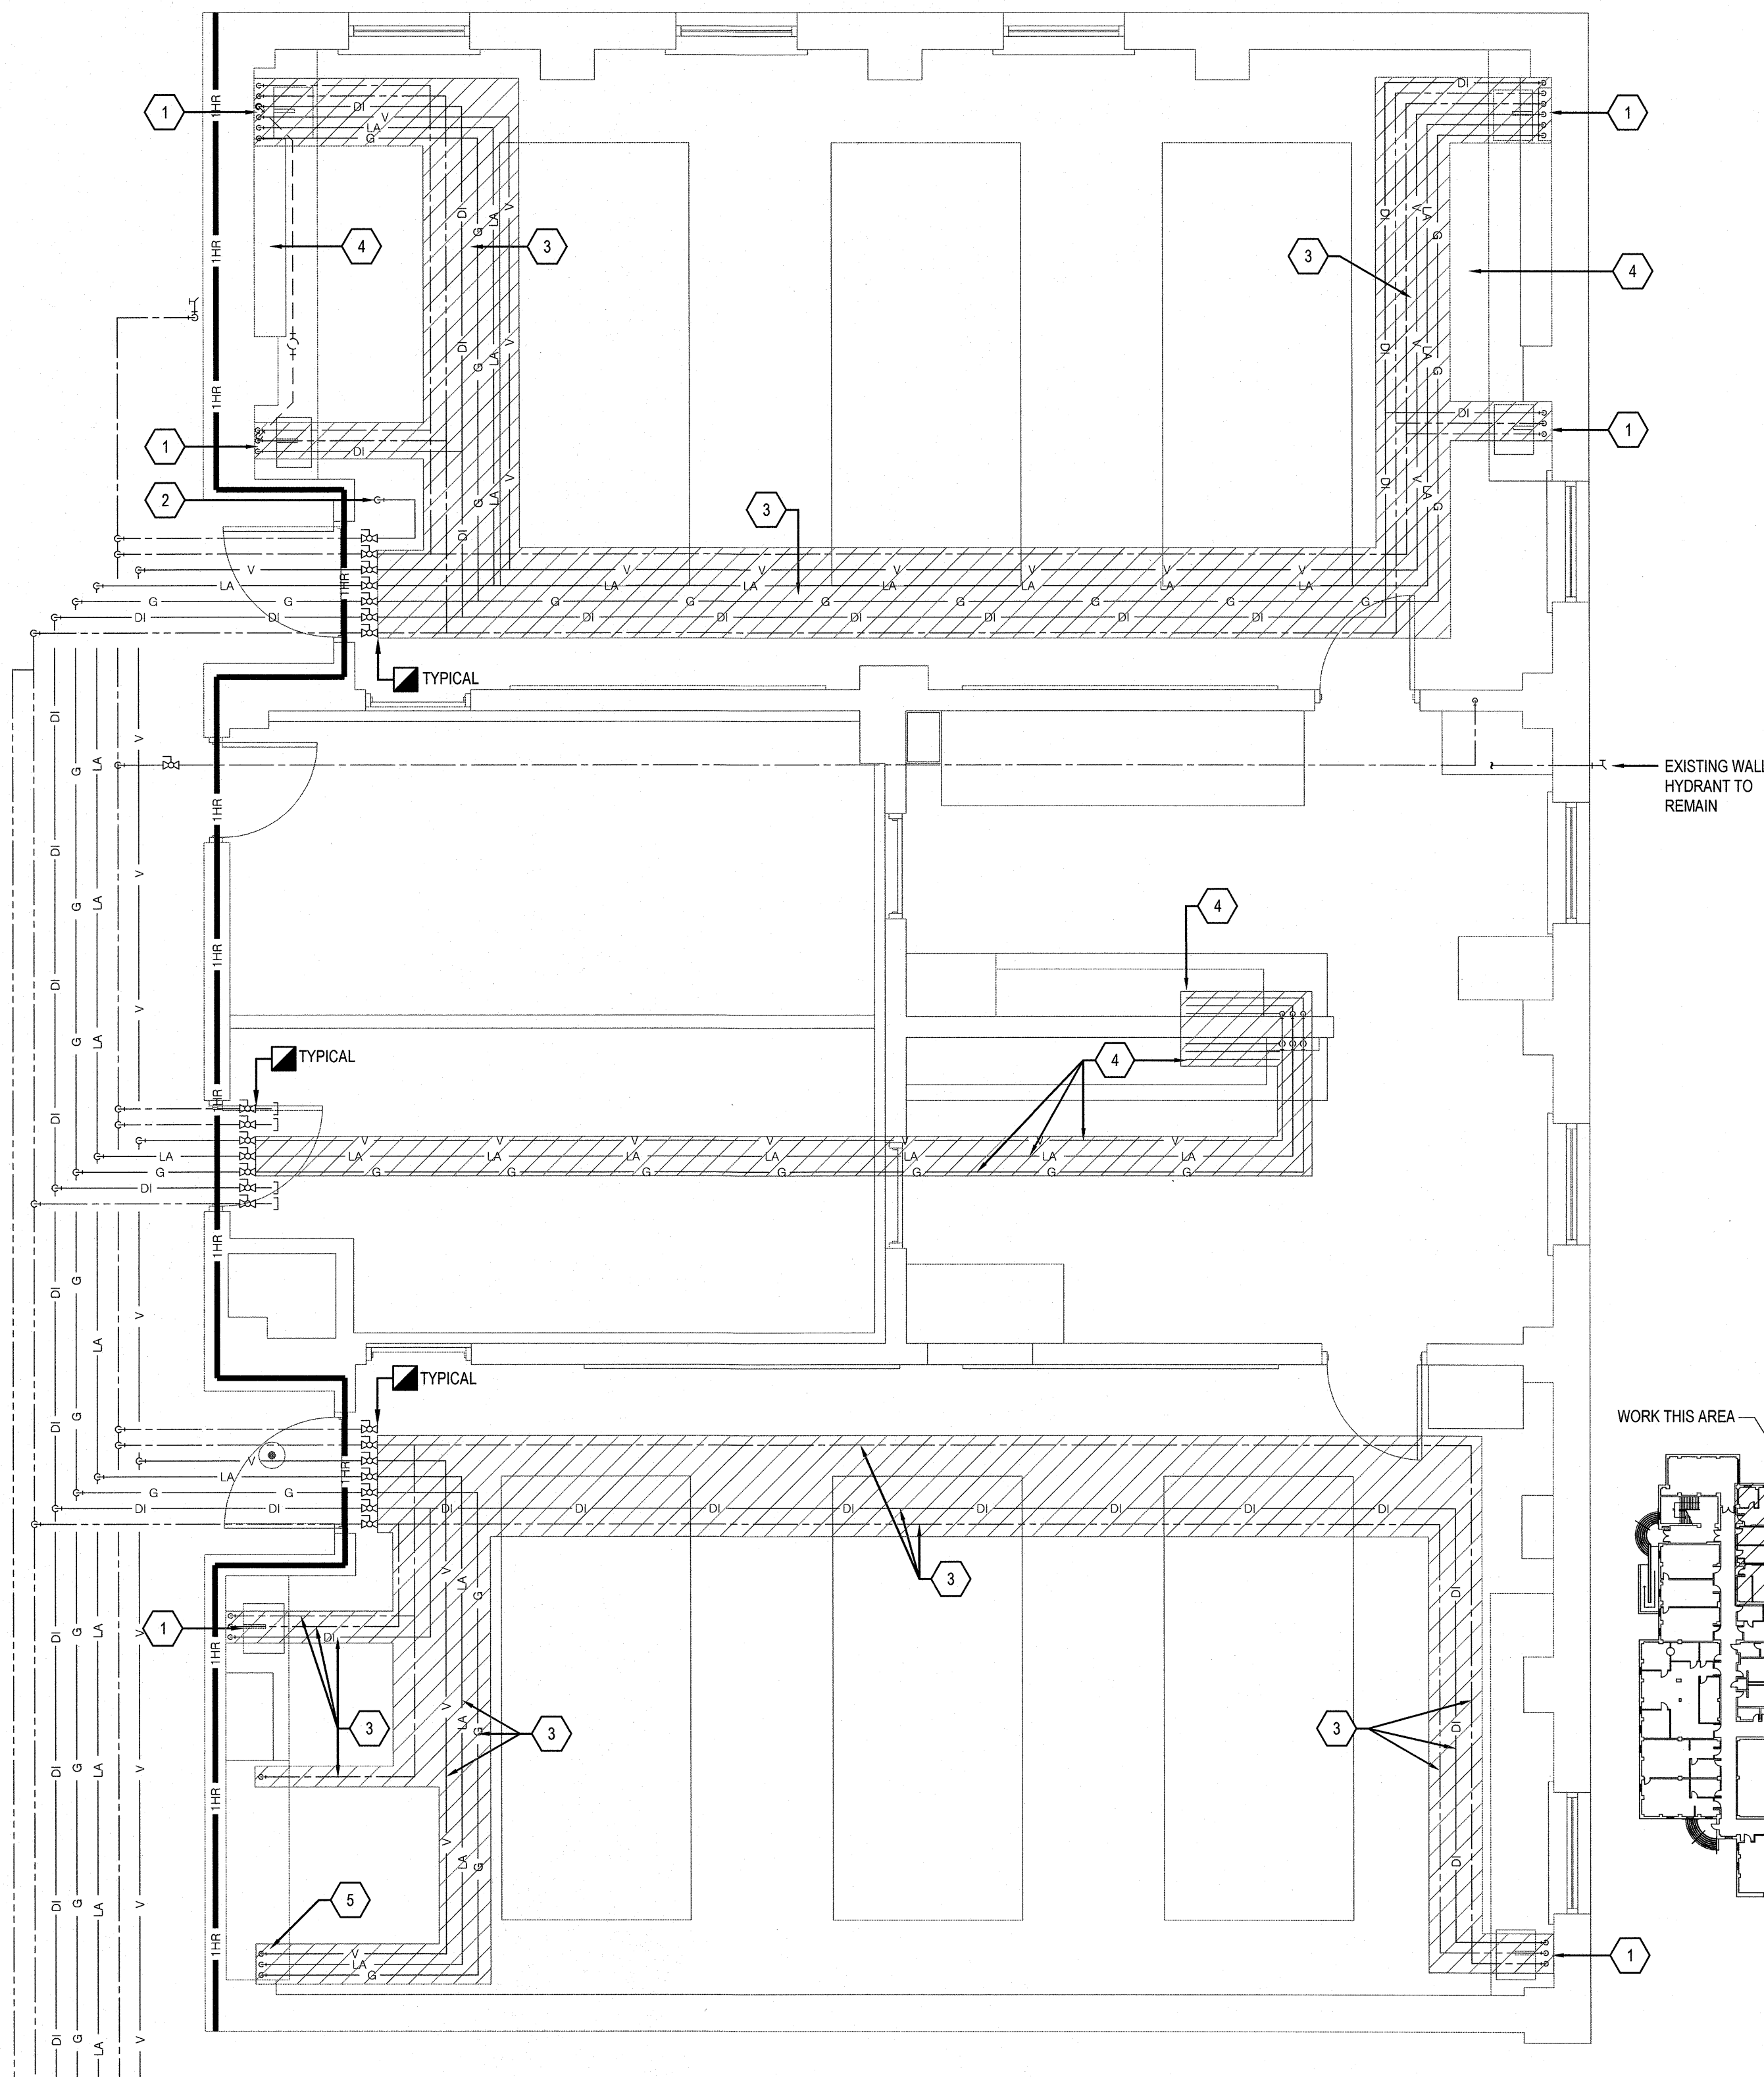


2 - LAB GASES AND WATER DEMOLITION PLAN
1/4" = 1'-0"

RECORD DRAWING
These Record Documents have been prepared based on information provided by others. The Engineer has not verified the accuracy and/or completeness of this information and shall not be responsible for any errors or omissions which may be incorporated herein as a result.

Dated: 2017-10-13

By:

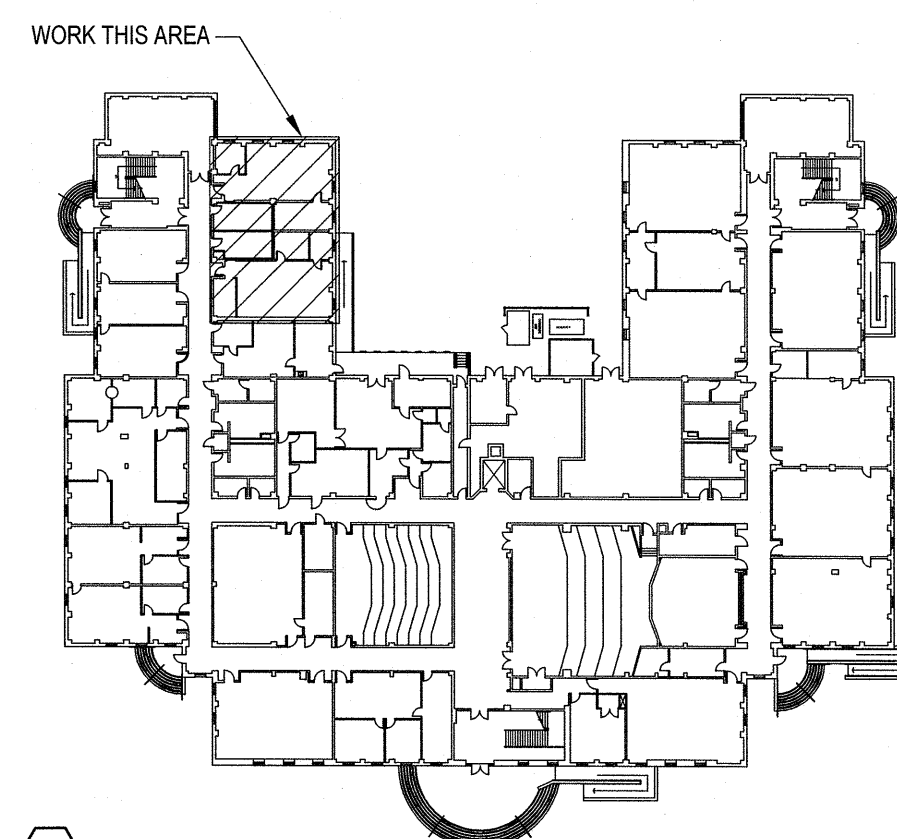


KEY PLAN

NOT TO SCALE

FIRE WALL LEGEND

1 HR FIRE PARTITION

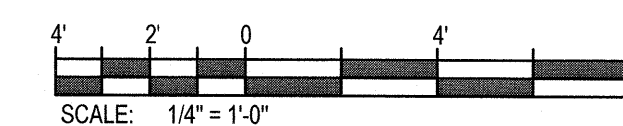

UNIVERSITY OF NORTH CAROLINA WILMINGTON
DOBO HALL LABS 117 AND 119 RENOVATIONS
601 S. COLLEGE ROAD, WILMINGTON, NORTH CAROLINA 28403
STATE ID# 17-1697-501A

PLUMBING PIPING DEMOLITION PLANS

Job No.: 10290
Drawn: JBS
Designed: JBS
Checked: DMH

Drawing No:

PD1.1

Revision:
1

CBHF
Engineers, PLLC

2246 Yaupon Drive
Wilmington, NC 28401
Phone: 910.791.4000
Fax: 910.791.5266
www.cbhfindesign.com
© Copyright 2017 CBHF Engineers, PLLC
NC# P-0060



Revision	Date
1	10.13.17