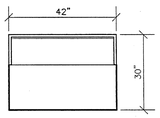

PLAN

NOTE:
ALL MATERIAL U.O.N. SHALL BE 3/4" OAK PLYWOOD WITH 1/4" SOLID OAK EDGES. FINISHED ALL AROUND

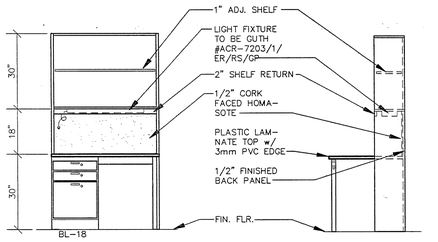

FRONT ELEVATION

SIDE ELEVATION

1 DESK UNIT (TYPICAL)
SCALE: 1/2" = 1'-0"

EARL WALLS ASSOCIATES © 1993

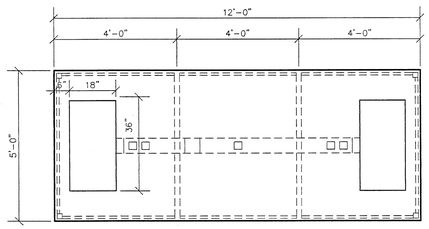

PLAN
SCALE: 1/2" = 1'-0"

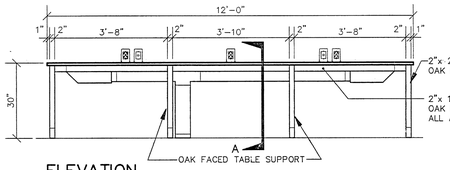

ELEVATION
SCALE: 1/2" = 1'-0"

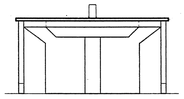

END ELEVATION
SCALE: 1/2" = 1'-0"

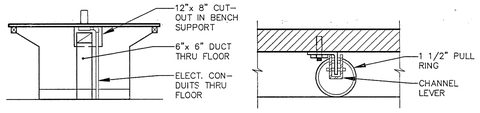

SECTION — A
SCALE: 1/2" = 1'-0"

DETAIL — B
SCALE: NONE

3 DOWN DRAFT BENCH DETAIL
SCALE: AS NOTED

EARL WALLS ASSOCIATES © 1993

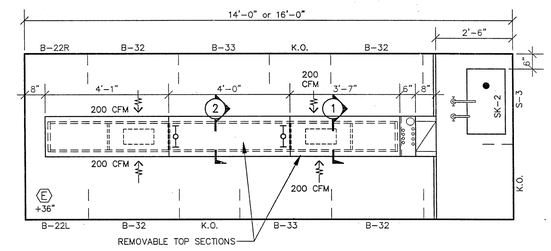

PLAN

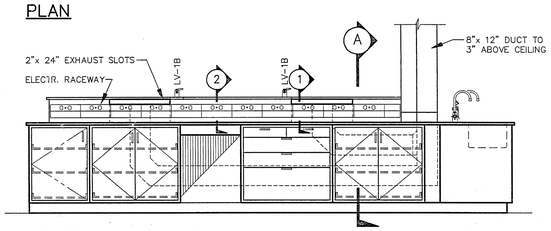

ELEVATION

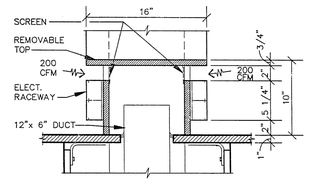

1 DETAIL
SCALE: 1 1/2" = 1'-0"

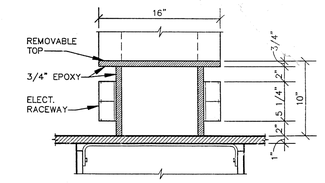

2 DETAIL
SCALE: 1 1/2" = 1'-0"

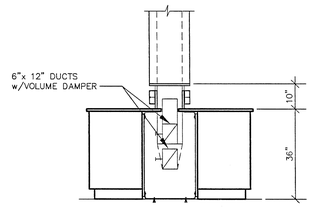

SECTION — A

2 BIO/CHEM BENCH
SCALE: 1/2" = 1'-0"

EARL WALLS ASSOCIATES © 1993

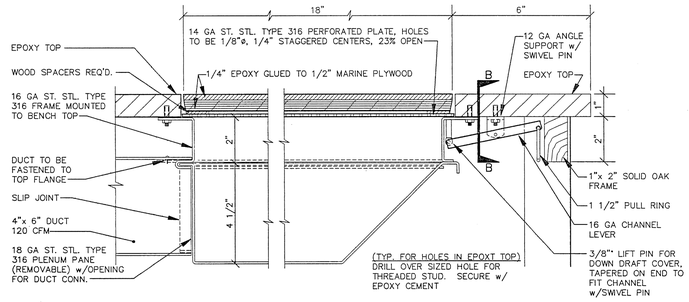

DOWN DRAFT DISSECTING PANEL
SCALE: NONE

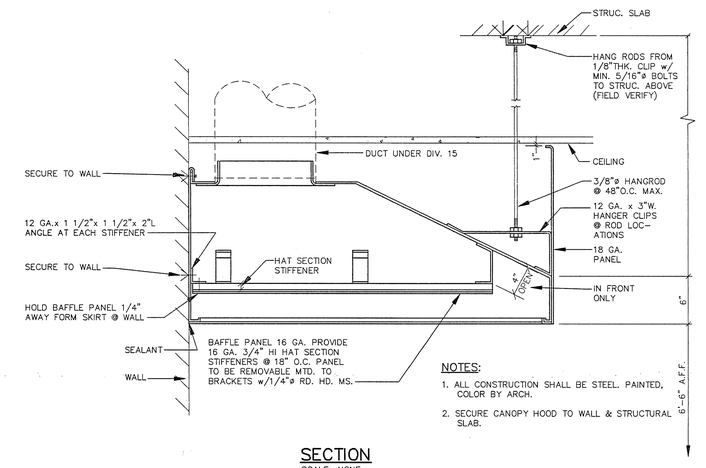

NOTES:
1. ALL CONSTRUCTION SHALL BE STEEL, PAINTED, COLOR BY ARCH.
2. SECURE CANOPY HOOD TO WALL & STRUCTURAL SLAB.

SECTION
SCALE: NONE

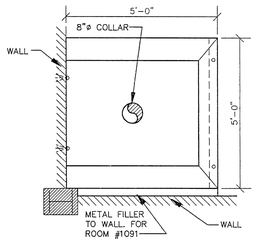

PLAN (RM. 1091)
SCALE: 3/4" = 1'-0"

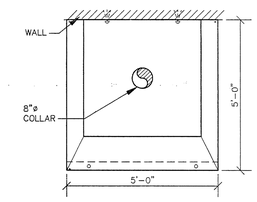

PLAN (RM. 2014)
SCALE: 3/4" = 1'-0"

4 CANOPY HOOD DETAIL
SCALE: AS NOTED

EARL WALLS ASSOCIATES © 1993

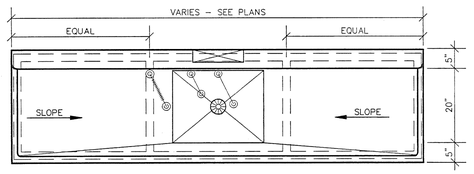

PLAN VIEW
SCALE: 3/4" = 1'-0"

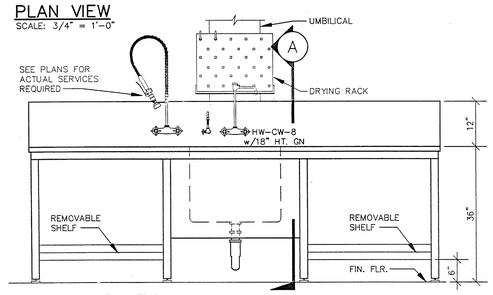

FRONT ELEVATION
SCALE: 3/4" = 1'-0"

NOTE:
1. ALL SHEET METAL WORK TO BE 16 GA. ST. STL.
2. ALL FRAME & LEG MEM-BERS TO BE 2" SQ. ST. STL. 16 GA. MIN. WITH WELDED CONNECTION
3. APPLY SOUND DEADEN-ING MATERIAL TO UNDER-SIDE OF SINK BASIN & BACKSPLASH.
4. FOR SERVICES SEE INDI-VIDUAL FLOOR PLANS.

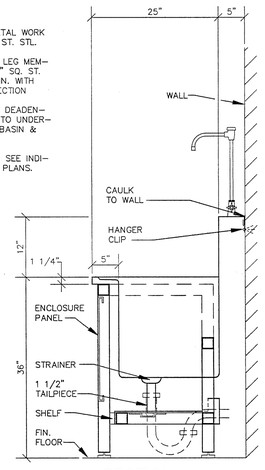

SECTION — A
SCALE: 1" = 1'-0"

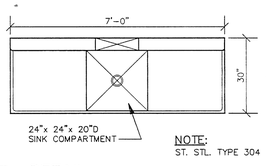

NOTE:
ST. STL. TYPE 304

5a DETAIL (RM. #2014)
SCALE: 1/2" = 1'-0"

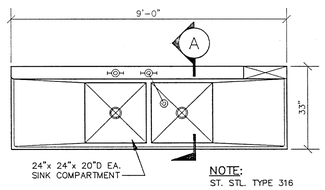

NOTE:
ST. STL. TYPE 316

5b DETAIL (RM. #1079)
SCALE: 1/2" = 1'-0"

5 GLASSWASH SINK DETAIL (BIOLOGY LAB PREP RM. #2014 & ANIMAL HOUSE RM. #1079)
AS NOTED

EARL WALLS ASSOCIATES © 1993

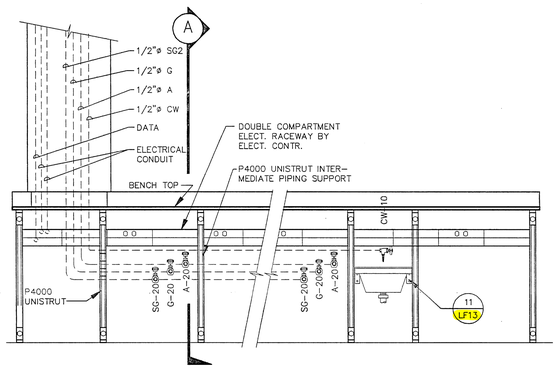

ELEVATION @ BACK OF BENCH

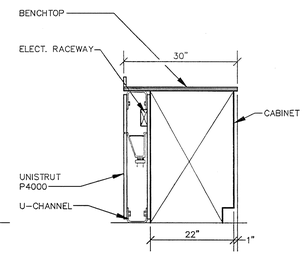

SECTION — A

6 SPLIT BENCH DETAIL
SCALE: 3/4" = 1'-0"

EARL WALLS ASSOCIATES © 1993

AS BUILT

Earl Walls Associates
Laboratory Design Consultants
5348 Carroll Canyon Road
San Diego, California 92121
(619)457-2400

DRAWING REVISIONS:

NO.	DATE:	REMARKS:

DATE: 5/16/94
PROJECT#: 8962
DESIGNED BY: PJK
DRAWN BY: MGM
CHECKED BY: PJK
CHECKED BY:

SHEET NO.: LF17

JEFFERIES AND FARIS ASSOCIATES
ARCHITECTS ■ PLANNERS
SEA TOWERS SUITE 201
2002 EASTWOOD ROAD
WILMINGTON, N.C. 28403
TEL: 910.256.6633
FAX: 910.256.9088

SCIENCE BUILDING
UNIVERSITY OF NORTH CAROLINA AT WILMINGTON
CODE 41336 ITEM 301 ID#6084280301A

SHEET TITLE:
LAB FURNISHINGS DETAILS