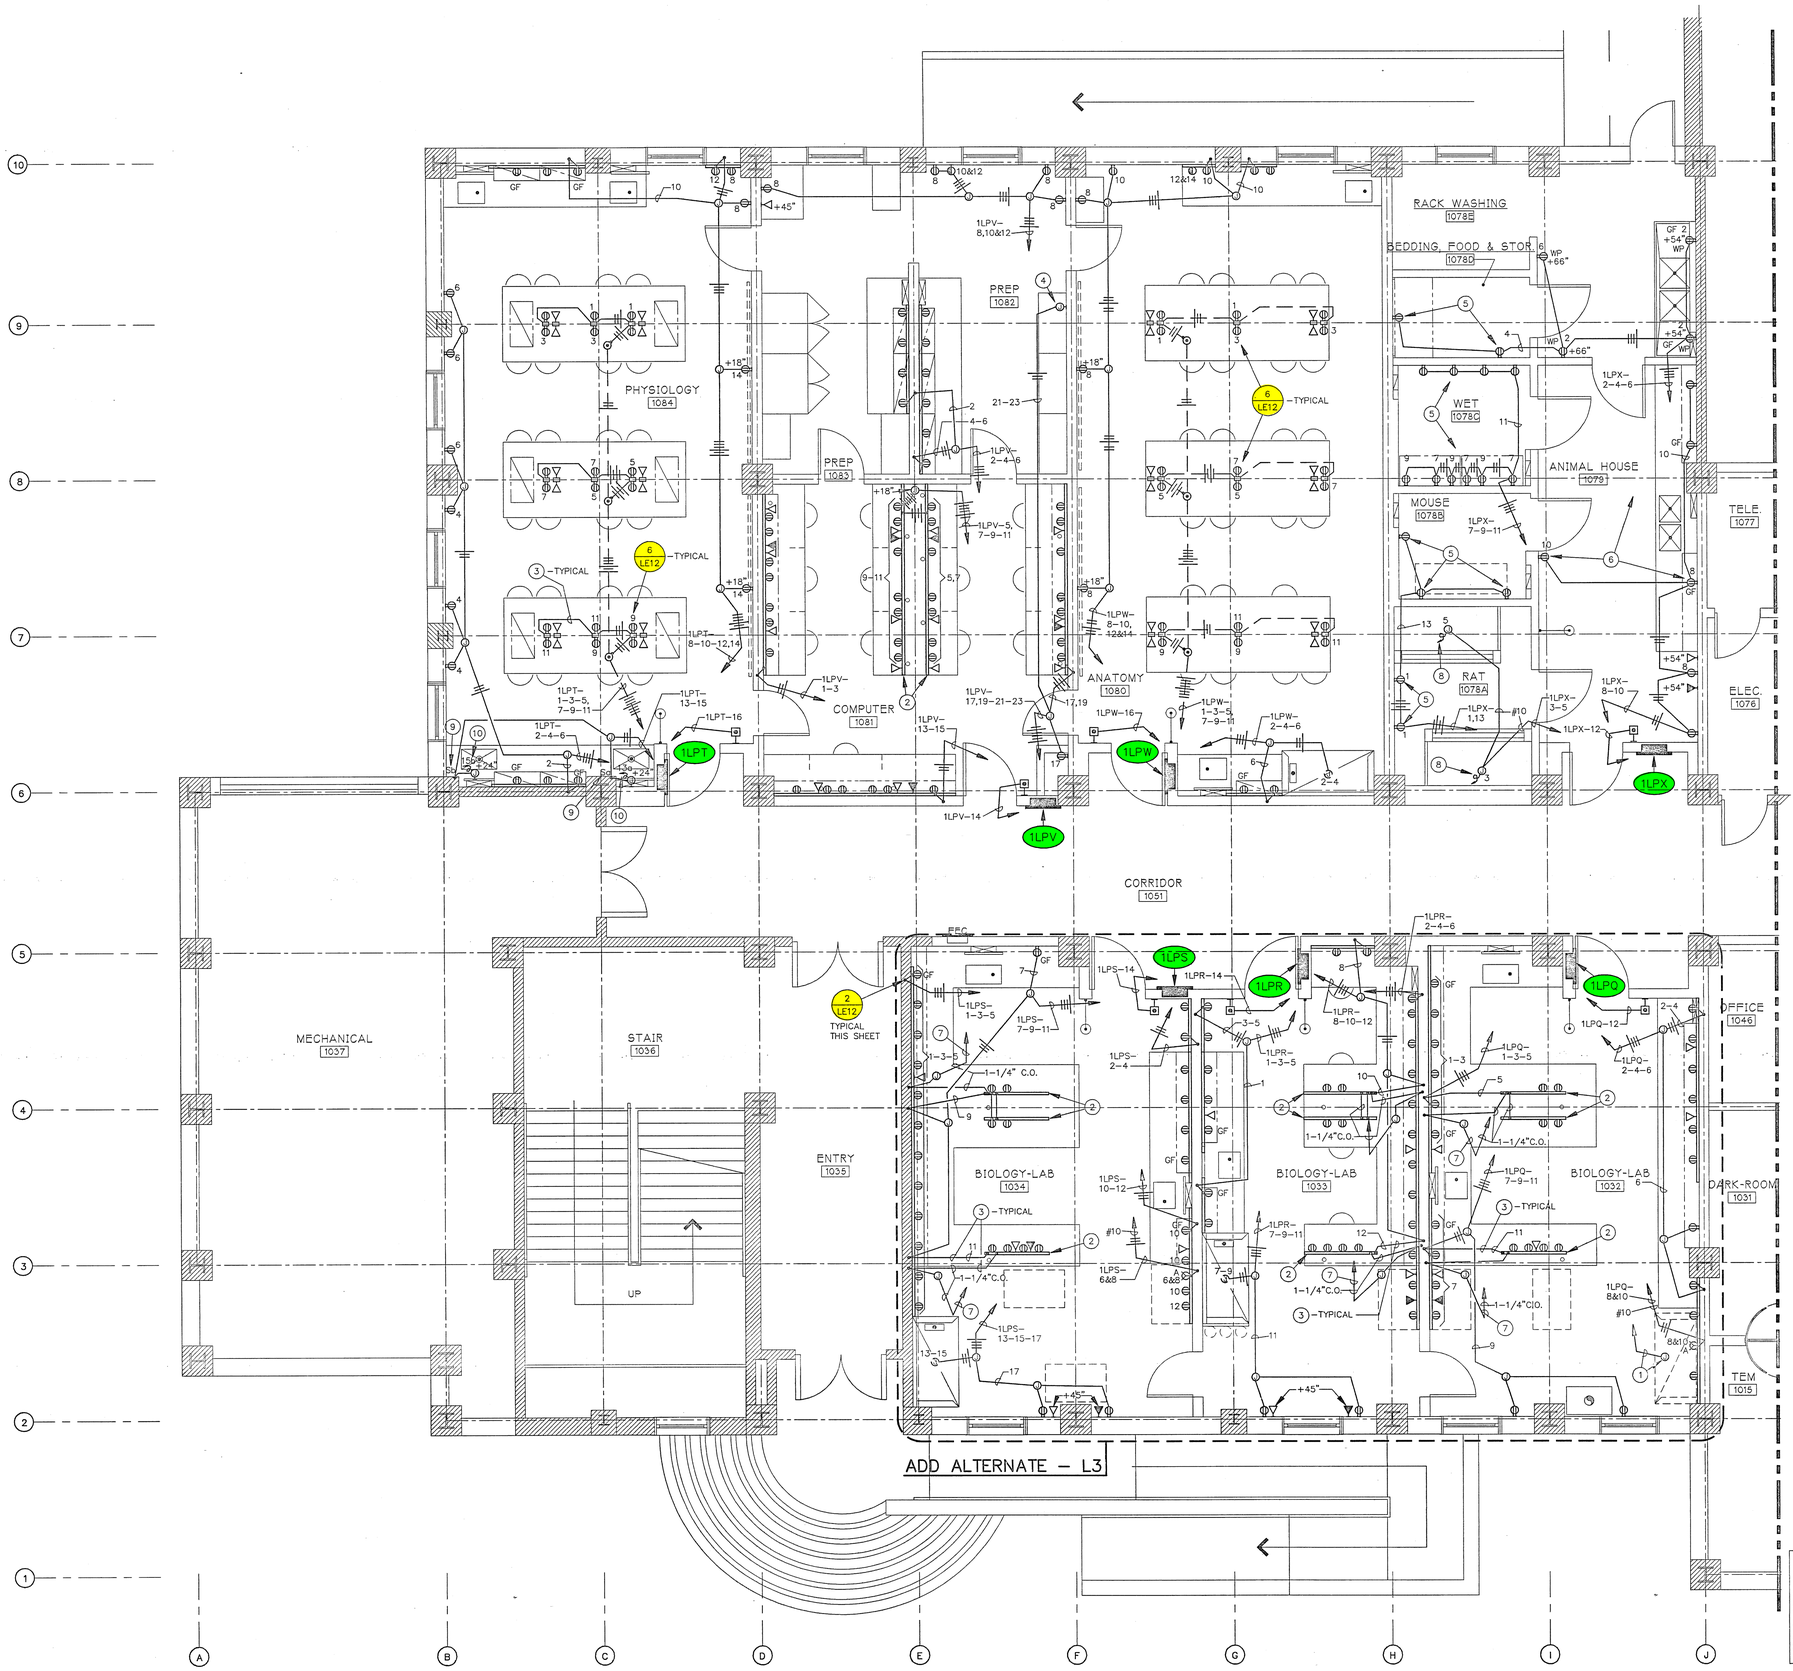

GENERAL ELECTRICAL PLAN

BUILDING KEYMAP

JEFFERIES AND FARIS ASSOCIATES
ARCHITECTS ■ PLANNERS
SEA TOWERS SUITE 201
2002 EASTWOOD ROAD
WILMINGTON, N.C. 28403
TEL: 910.256.6633
FAX: 910.256.9088

REFERENCE NOTES:

1. PROVIDE JUNCTION BOX IN ACCESSIBLE CEILING SPACE AND RUN 3/4"C.O. TO PANEL 1LPQ – FOR FUTURE FUME HOOD.
2. INSTALL RACEWAYS UNDER BENCH AT +18". SEE LAB FURNITURE DRAWINGS.
3. RUN CONDUIT UNDER BENCH.
4. WITH BLANK COVER. LEAVE 12" TAPED PIGTAILS IN BOX FOR FUTURE.
5. ALL RECEPTACLES IN ANIMAL AREAS 1078A, 1078B, 1078C AND BEDDING/FOOD STOR. SHALL BE WEATHERPROOF TYPE, INSTALLED AT +66".
6. ALL RECEPTACLES IN ANIMAL HOUSE 1079 SHALL BE WEATHERPROOF TYPE, INSTALLED AT +54".
7. TO NEARBY TELCO/DATA CLOSET. SEE CATEGORY "E" BUILDING ELECTRICAL DRAWINGS.
8. W.P., CEILING MOUNTED. CONNECT TO ANIMAL CUBICLE.
9. ENGRAVE SWITCHPLATE "DISPOSER"
10. CONNECT TO 1/2 HP, 120V DISPOSER.

SCIENCE BUILDING
UNIVERSITY OF NORTH CAROLINA AT WILMINGTON
CODE 44366 ITEM 301 ID#6062280301A

SHEET TITLE:
FIRST FLOOR PLAN - AREA ONE WEST

SYMBOLS

FIRST FLOOR
SCALE: 1/4" = 1'-0"

AREA ONE AS BUILT

Earl Walls Associates
Laboratory Design Consultants
5348 Carroll Canyon Road
San Diego, California 92121
(619)457-2400

DRAWING REVISIONS:		
NO.	DATE:	REMARKS:

DATE:	5/16/94
PROJECT#:	8962
DESIGNED BY:	JSG
DRAWN BY:	MS
CHECKED BY:	JSG
CHECKED BY:	

SHEET NO.: LE1