\\G2400\data\WG Master File Structure\Projects\2004\0414.MASS\Photos and Images\111004\DSC07187.JPG

\\G2400\data\WG Master File Structure\Projects\2004\0414.MASS\Photos and Images\111004\DSC07186.JPG

C Interior Existing Conditions
Not to scale

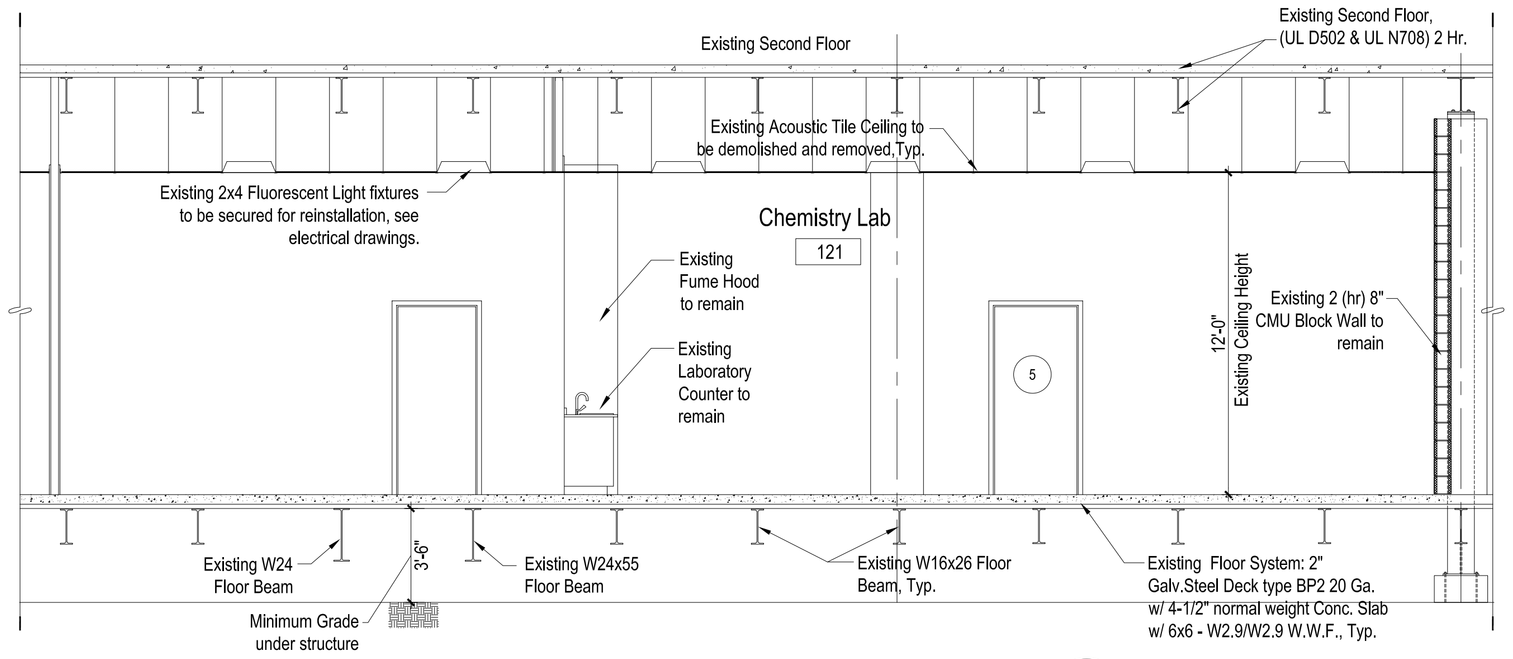

B Interior Existing Conditions
Not to scale

D Typical Section
1/4" = 1'-0"

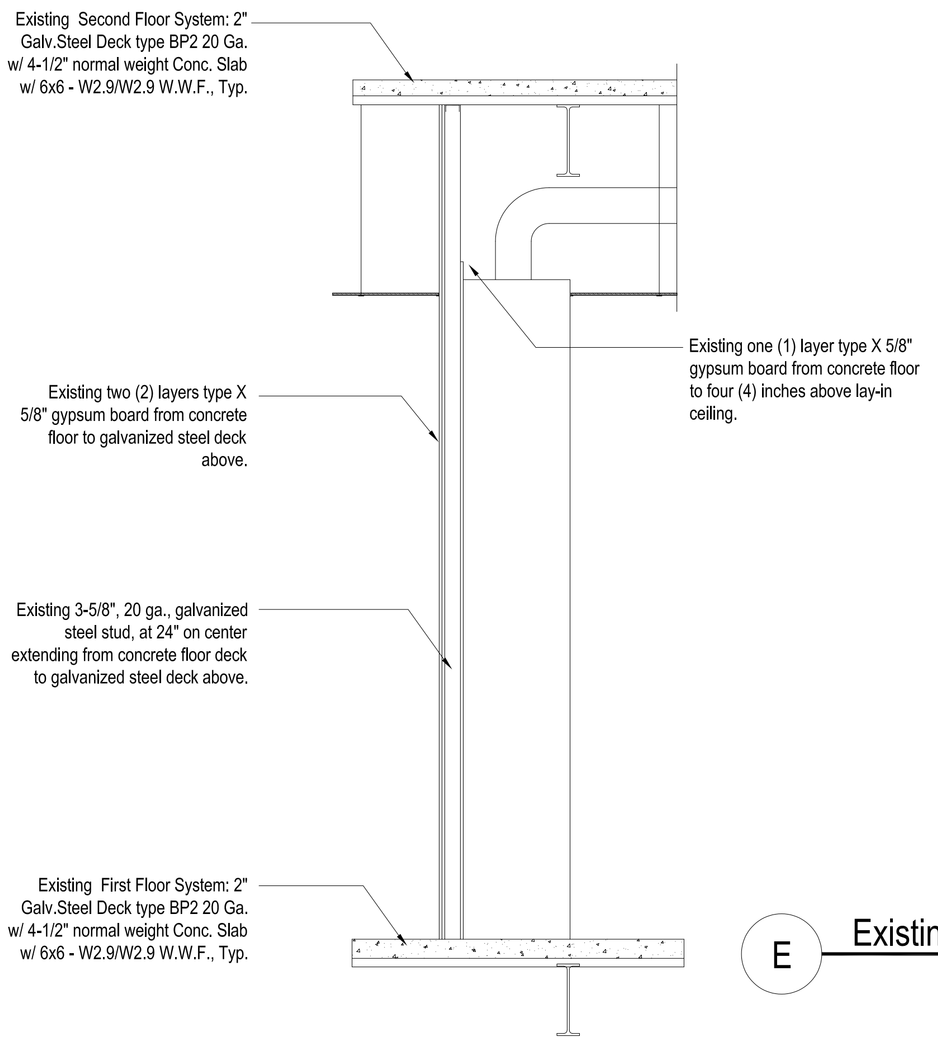

E Existing Wall Section
1/2" = 1'-0"

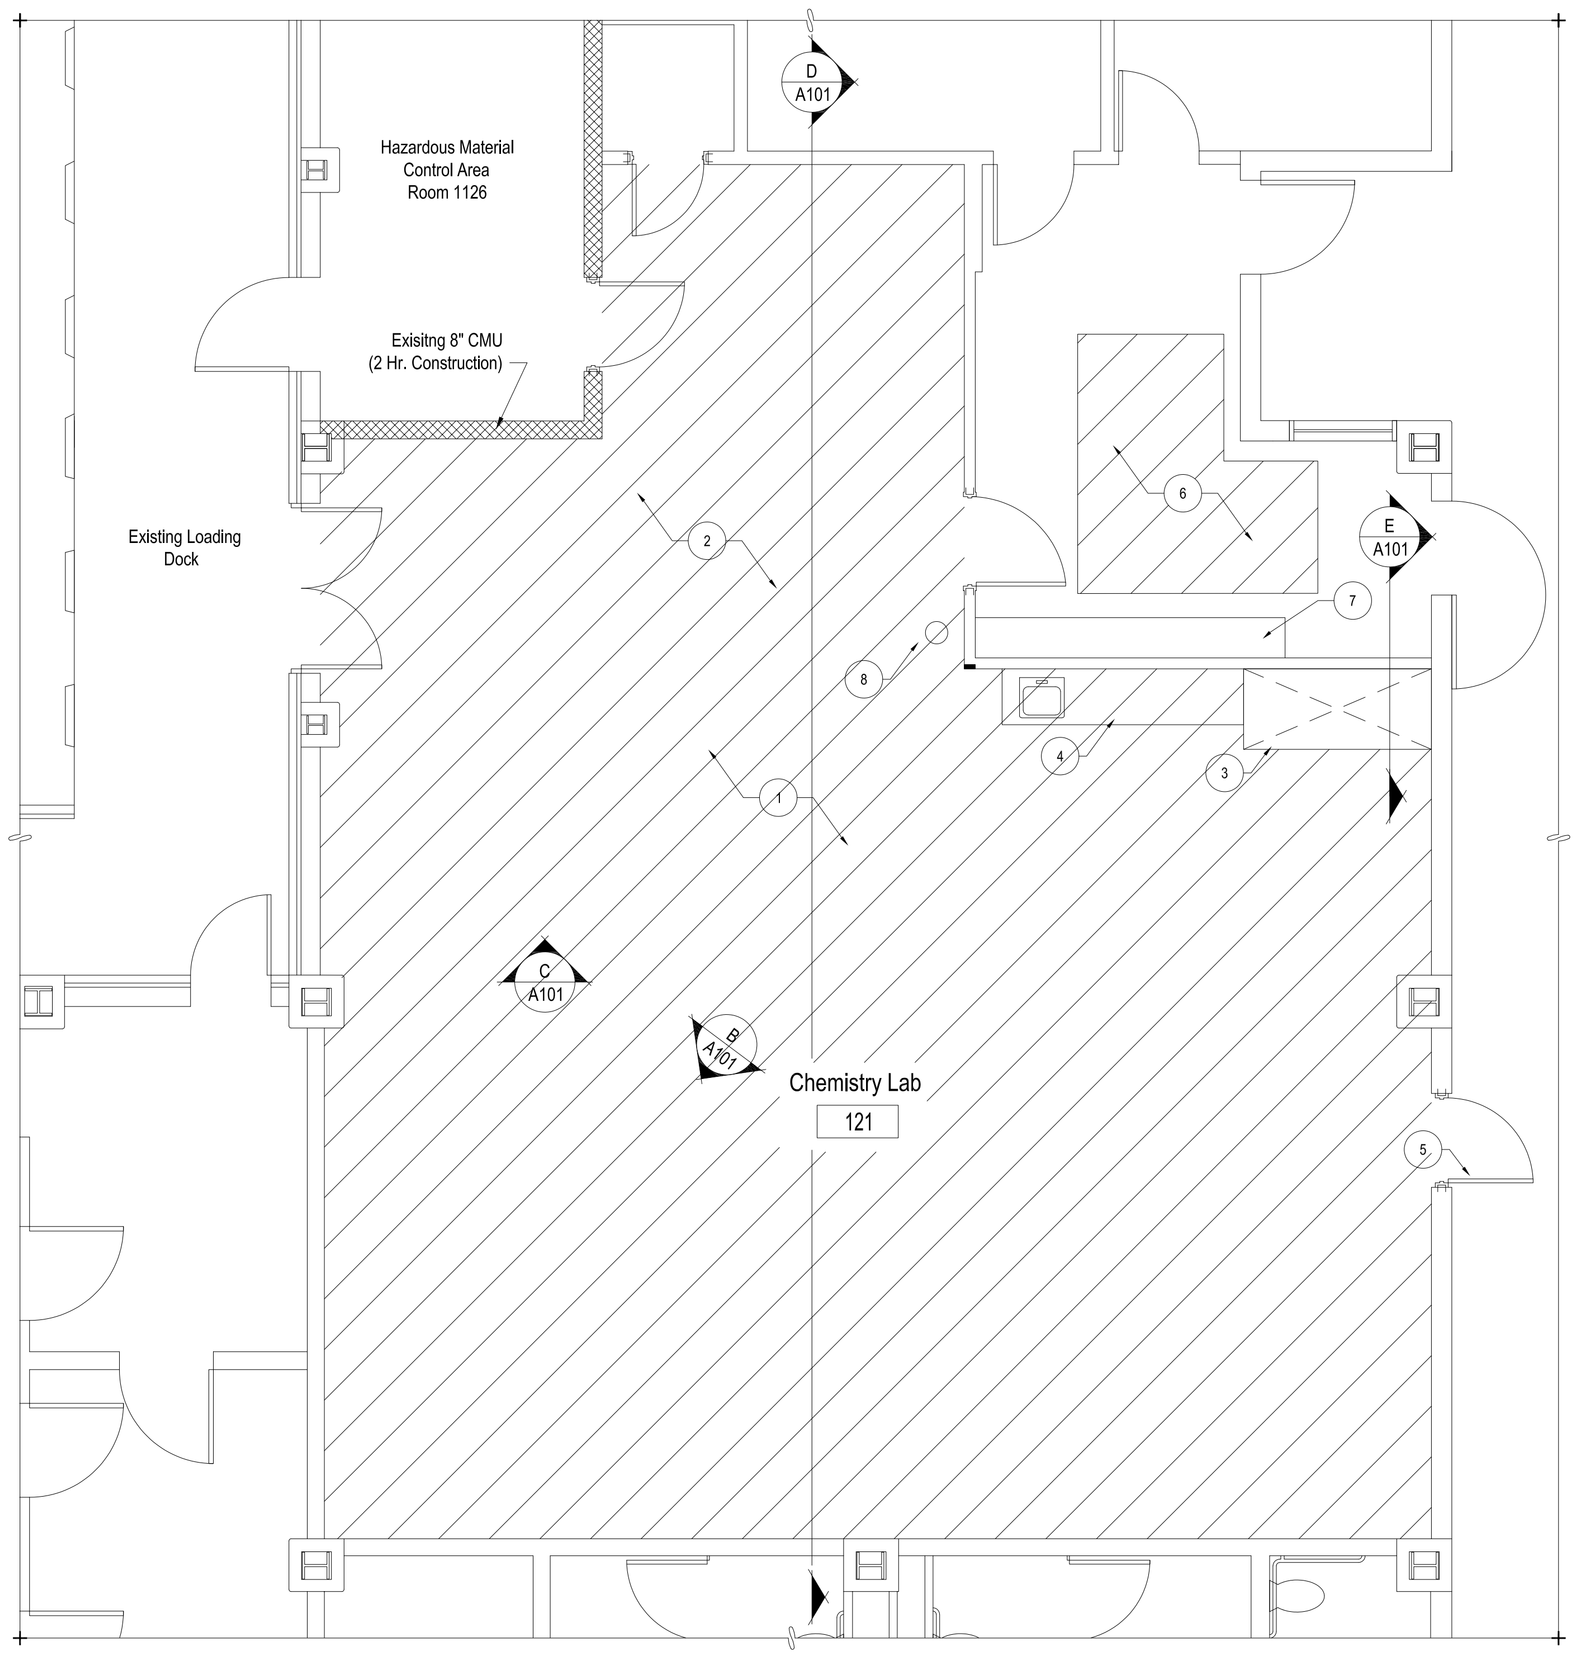

A Demolition Plan
1/4"=1'-0"

General Notes

See Mechanical and Electrical drawings for balance of demolition notes.
Coordinate work of other trades with Architectural work.

Keyed Notes:

1. Contractor to demolish and remove existing ceiling grid and acoustical ceiling panels in preparation for replacement. Contractor to secure existing 2 x 4 light fixtures for reinstallation, see electrical demolition plan.
2. Existing sanded epoxy painted floor to remain. Contractor to protect existing sanded epoxy painted floor during demolition and construction.
3. Existing fume hood to remain. Contractor to protect fume hood during demolition and construction.
4. Existing laboratory cabinet to remain. Contractor to protect cabinet during demolition and construction.
5. Existing door and frame to remain.
6. Contractor to selectively demolish and remove acoustical ceiling panels and ceiling grid, see mechanical demolition plan.
7. Existing wooden bookcase to remain. Contractor to protect from damage during demolition and construction.
8. Relocate emergency safety shower, see Architectural A-102.

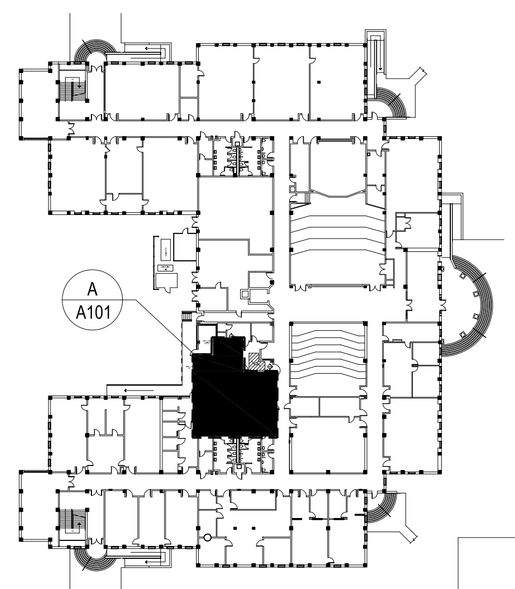

Key Plan
Scale: 1"=60'
NORTH

Record Drawings

These Drawings were created for the Owner's use. They represent actual installed conditions as indicated by Contractor mark-ups, Change Order's and clarification Sketches Issued by the Designers. To the best of my knowledge they are correct and complete.

WALKER GROUP ARCHITECTS
incorporated
PO BOX 541, NEW BERN, NC 28563
252-636-8778 252-636-8992(FAX)

JERRY LEE WALKER REGISTERED ARCHITECT 8181 NORTH CAROLINA NEW BERN, NC

University of North Carolina at Wilmington
602 South College Road
Wilmington, NC 28403

Dobo Hall
Chemistry Lab 121
Renovation

UNCW
601 South College Road
Wilmington, NC 28403
910-962-3000
www.uncw.edu

Revisions

No.	Date	
1	06/15/05	Record Drawings

Project Number 0414.MASS
Date 3/21/2005
Drawn TJC
Checked JLW
Scale As Noted
Drawing Title
Demolition: Chemistry Lab 121

Sheet Number 3 of 12
Drawing Number A-101