University of North Carolina at Wilmington

Renovations to Chemistry Lab 121, Dobo Hall

Index of Drawings:

1 of 12	G-101	Title Sheet & Index of Drawings
2 of 12	G-102	Code Summary and Key Plan
3 of 12	A-101	Demolition Plan, Section and Keyed Notes
4 of 12	A-102	Renovated Floor Plan, Enlarged Plan and Section
5 of 12	A-103	Reflected Ceiling Plan
6 of 12	M-001	Mechanical Legends, Notes, Schedules and Details
7 of 12	M-101	Mechanical Demolition: Chemistry Lab 121
8 of 12	M-102	Mechanical HVAC Plan: Chemistry Lab 121
9 of 12	E-001	Electrical Legend, Notes, Schedules and Details
10 of 12	E-101	Electrical Power Plan: Chemistry Lab 121
11 of 12	E-102	Electrical Power Plan: Chemistry Lab 121
12 of 12	E-103	Electrical Lighting and Fire Alarm Plan and Schedule

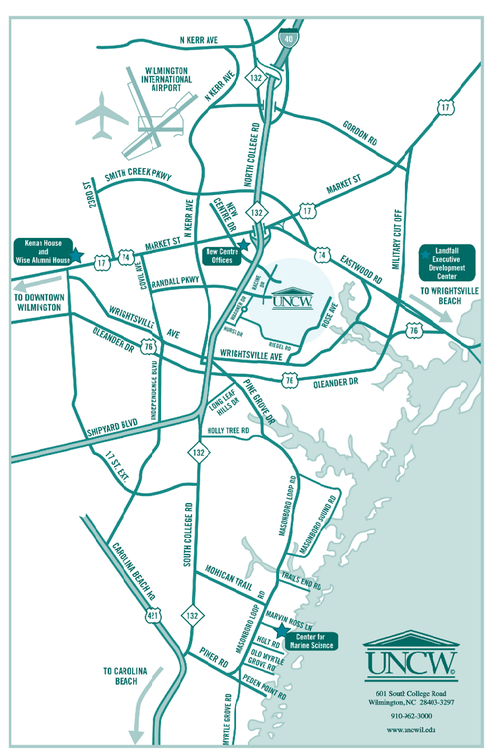

Area Map

THE UNIVERSITY OF NORTH CAROLINA AT WILMINGTON

MAIN CAMPUS LEGEND

Academic Support Center	44	Graham Residence Hall	30	Honors House	41	International House	40
Admissions (James Hall)	9	Hanover Hall Gymnasium	11	Housing and Residence Life Office and Activity Centr	37	James Hall (Admissions, Cashier, Financial Aid, Grad School, Registrar)	9
Alderman Hall (Administration)	7	Hewlett Residence Hall	31	Housing Warehouse	53		
Bear Hall	19	Hoggard Hall	8				
Belk Residence Hall	28						
Bookstore	15						
Burney Center	15						
Business Applications	52						
Cameron Hall	24						
Cornerstone Hall	41A						
DeLoach Hall	A						
Dobo Hall	25						
Environmental Health and Safety	42A						
Facilities	47						
Facilities Trade Shops	50						
Fine Arts Scene Shop	45						
Friday Annex	22						
Friday Hall	20						
Galloway Residence Hall	29						
Gazebo	33						
Grad Student Offices	20A						

Kenan Auditorium	1
Kenan Hall	5
King Hall	4
Kresge Greenhouse	21
Leutze Hall (Formerly Lakeside)	17
Madeline Suite (Wagoner Hall)	39A
Morton Hall	18
Natatorium (Swimming Pool)	12
Nixon Annex, Trask Coliseum	13
Printing Services	46
Psychopharmacology Lab	20B
Purchasing Services	51
Randall Library	3
Receiving	42
Registrar	9
Small Business and Technology Development Center	27
School of Education	23
Schwartz Residence Hall	35
Shinn Plaza	40A
Social and Behavioral Sciences	26
Student Recreation Center	34
Suites Services Building	38
Telecommunications	43
Trask Coliseum	10
University Apartments	32
University Police	48
University Suites	36
University Union	16
Wagoner Hall (Dining)	39
Warwick Center	14
Westside Hal	6
Under Construction	

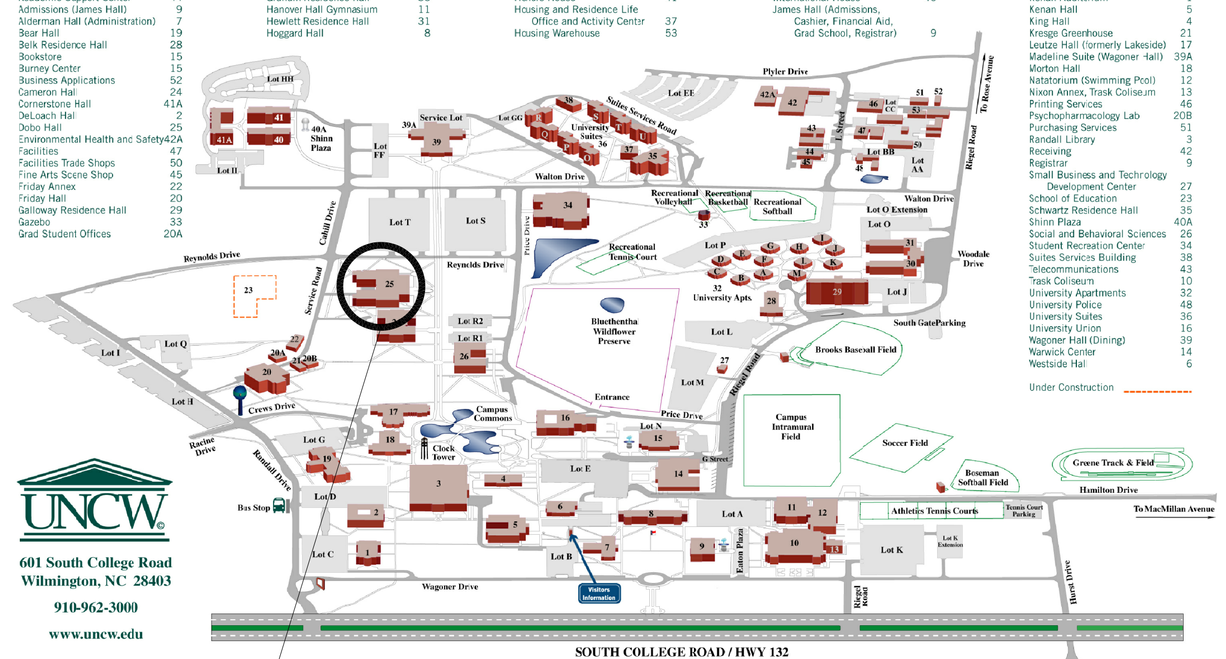

UNCW
601 South College Road
Wilmington, NC 28403
910-962-3000
www.uncw.edu

Campus Map

Dobo Hall

Architectural Abbreviations

APC.	ACOUSTICAL PANEL CEILING	EXT.	EXTERIOR	OC	ON CENTER
ADJ.	ADJACENT	F.D.	FLOOR DRAIN	OH.	OVERHANG
AFF	ABOVE FINISHED FLOOR	FDN.	FOUNDATION	OHD.	OVERHEAD
AL.	ALUMINUM	F.E.	FIRE EXTINGUISHER	OPNG.	OPENING
ALT.	ALTERNATE	FFE	FINISHED FLOOR ELEVATION	PART.	PARTITION
ATTN.	ATTENUATION	FL.	FLOOR	P.E.M.B.	PRE-ENGINEERED METAL BLDG.
BD.	BOARD	FT	FIRE RETARDANT TREATED	PC	PLUMBING CONTRACTOR
BIT.	BITUMINOUS	FTG.	FOOTING	PL.	PLATE
BLKG.	BLOCKING	FUR.	FURRING	P.	PAINTED
BLKT.	BLANKET	GA.	GAUGE	REF.	REFRIGERATOR
BM.	BEAM	GALV.	GALVANIZED	REQD.	REQUIRED
BOP	BOTTOM OF PLATE	GB	GRAB BAR	RM.	ROOM
CAB.	CABINET	GC	GENERAL CONTRACTOR	RO.	ROUGH OPENING
CB	CATCH BASIN	GL.	GLASS	SF	SQUARE FEET
℄	CENTERLINE	GYP.BD.	GYPSUM BOARD	SIM.	SIMILAR
CLG.HT.	CEILING HEIGHT	HDW	HARDWARE	SPECS.	SPECIFICATIONS
CJ	CONTROL JOINT	HM	HOLLOW METAL	S.S.	STAINLESS STEEL
CLR.	CLEAR	HP	HIGH POINT	STD.	STANDARD
CLG.	CEILING	HT.	HEIGHT	STL.	STEEL
CMU	CONCRETE MASONRY UNIT	HVAC	HEATING/VENTILATION, AIR CONDITIONING	STRUCT.	STRUCTURE/STRUCTURAL
COL.	COLUMN			SUSP.	SUSPENDED
CONC.	CONCRETE	INT.	INTERIOR	TC	TOP CURB
CONSTR.	CONSTRUCTION	INSUL.	INSULATION	TG	TOP GRATE
CONT.	CONTINUOUS	INV.	INVERT	TEMP.	TEMPERED
CONTR.	CONTRACTOR	JT.	JOINT	THK.	THICK
CT	CERAMIC TILE	LAV.	LAVATORY	TJ	TOP OF JOIST
DWG.	DRAWING	LP	LOW POINT	TOM	TOP OF MASONRY
EA.	EACH	MANUF.	MANUFACTURER	TOP	TOP OF PLATE
EC	ELECTRICAL CONTRACTOR	MC	MECHANICAL CONTRACTOR	TOS	TOP OF SLAB
EF	EXHAUST FAN	MH.	MANHOLE	TOW	TOP OF WALL
ELEC.	ELECTRICAL	MECH.	MECHANICAL	TYP.	TYPICAL
ENCL.	ENCLOSURE	MIN.	MINIMUM	TS	TOP OF STEEL
EOS	EDGE OF SLAB	MO.	MASONRY OPENING	TS	TUBE STEEL
EQC.	EQUIPMENT CONTRACTOR	MTD.	MOUNTED	VERT.	VERTICAL
EWC	ELECTRIC WATER COOLER	MTL.	METAL	VIF	VERIFY IN FIELD
EXIST.	EXISTING	NC	NOT IN CONTRACT	WD.	WOOD
EXPD.	EXPOSED	N.T.S.	NOT TO SCALE	WDW.	WINDOW
EXP.JT.	EXPANSION JOINT			WWF	WELDED WIRE FABRIC
				W/	WITH

General Project Legend

ROOM NAME — Room Name
RM# — Room Number

X — Keyed Note Reference

XX / XX — Elevation Reference

Record Drawings

These Drawings were created for the Owner's use. They represent actual installed conditions as indicated by Contractor mark-ups, Change Order's and clarification Sketches issued by the Designers. To the best of my knowledge they are correct and complete.

THE WALKER GROUP ARCHITECTS
incorporated
PO BOX 541, NEW BERN, NC 28563
252-636-8778 252-636-8992(FAX)

JERRY LEE WALKER REGISTERED ARCHITECT 8181 NORTH CAROLINA NEW BERN, NC

University of North Carolina at Wilmington
602 South College Road
Wilmington, NC 28403

Dobo Hall
Chemistry Lab 121
Renovation

UNCW
601 South College Road
Wilmington, NC 28403
910-962-3000
www.uncw.edu

Revisions

No.	Date
1	06/15/05 Record Drawings

Project Number 0414.MASS
Date 3/21/2005
Drawn TJC
Checked JLW
Scale As Noted
Drawing Title

Title Sheet and Index of Drawings

Sheet Number 1 of 12
Drawing Number G-101