University of North Carolina at Wilmington

Dobo Hall

Computer Lab 230 Renovation

UNCW Campus

Wilmington, NC 28406

Index of Drawings:

1 of 10	G-101	Title Sheet & Index of Drawings
2 of 10	G-102	Code Summary & Life Safety Plan
3 of 10	A-101	Existing and Renovated Floor Plans
4 of 10	A-102	Exisitng and Renovated Reflected Ceiling Plans
5 of 10	A-103	Building Section, Wall Section and Schedules
6 of 10	M-101	New Floor Plan - Mechanical
7 of 10	E-101	Electrical Schedules, Notes and Details
8 of 10	E-102	Existing & New Floor Plan - Power
9 of 10	E-103	Existing & New Floor Plan - Lighting
10 of 10	FP-101	Existing & New Floor Plan - Fire Protection

WALKER the GROUP ARCHITECTURE incorporated
PO BOX 541, NEW BERN, NC 28563
252-636-8778 252-636-8992(FAX)

Record Drawings

University of North Carolina at Wilmington

602 College Road
Wilmington, NC 28403

Dobo Hall
Computer Lab 230 Renovation

Area Map

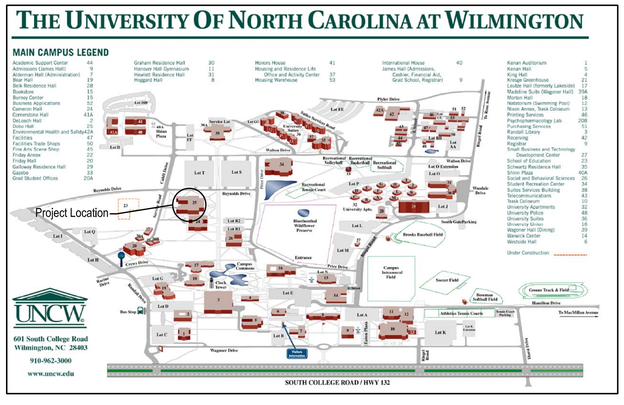

Vicinity Map

General Project Legend

ROOM NAME — Room Name
RM# — Room Number

X — Keynote Reference

XXX — Door Reference, see schedule

XX / XX — Elevation Reference

Record Drawings

These Drawings were created for the Owner's use. They represent actual installed conditions as Indicated by Contractor mark-ups, Change Order's and clarification Sketches Issued by the Desiigners. To the best of my knowledge they are correct and complete.

Architectural Abbreviations

APC	ACOUSTICAL PANEL CEILING	EXT.	EXTERIOR	OC	ON CENTER
ADJ.	ADJACENT	F.D.	FLOOR DRAIN	OH.	OVERHANG
AFF	ABOVE FINISHED FLOOR	FDN.	FOUNDATION	OHD.	OVERHEAD
AL.	ALUMINUM	F.E.	FIRE EXTINGUISHER	OPNG.	OPENING
ALT.	ALTERNATE	FFE	FINISHED FLOOR ELEVATION	PART.	PARTITION
ATTN.	ATTENUATION	FL.	FLOOR	P.E.M.B.	PRE-ENGINEERED METAL BLDG.
BD.	BOARD	FT	FIRE RETARDANT TREATED	PC	PLUMBING CONTRACTOR
BIT.	BITUMINOUS	FTG.	FOOTING	PL.	PLATE
BLKG.	BLOCKING	FUR.	FURRING	P.	PAINTED
BLKT.	BLANKET	GA.	GAUGE	REF.	REFRIGERATOR
BM.	BEAM	GALV.	GALVANIZED	REQD.	REQUIRED
BOP	BOTTOM OF PLATE	GB	GRAB BAR	RM.	ROOM
CAB.	CABINET	GC	GENERAL CONTRACTOR	RO.	ROUGH OPENING
CB	CATCH BASIN	GL.	GLASS	SF	SQUARE FEET
℄	CENTERLINE	GYP.BD.	GYPSUM BOARD	SIM.	SIMILAR
CLG.HT.	CEILING HEIGHT	HDW	HARDWARE	SPECS.	SPECIFICATIONS
CJ	CONTROL JOINT	HM	HOLLOW METAL	S.S.	STAINLESS STEEL
CLR.	CLEAR	HP	HIGH POINT	STD.	STANDARD
CLG.	CEILING	HT.	HEIGHT	STL.	STEEL
CMU	CONCRETE MASONRY UNIT	HVAC	HEATING,VENTILATION, AIR CONDITIONING	STRUCT.	STRUCTURE/STRUCTURAL
COL.	COLUMN	INT.	INTERIOR	SUSP.	SUSPENDED
CONC.	CONCRETE	INSUL.	INSULATION	TC	TOP CURB
CONSTR.	CONSTRUCTION	INV.	INVERT	TG	TOP GRATE
CONT.	CONTINUOUS	JT.	JOINT	TEMP.	TEMPERED
CONTR.	CONTRACTOR	LAV.	LAVATORY	THK.	THICK
CT	CERAMIC TILE	LP	LOW POINT	TJ	TOP OF JOIST
DWG.	DRAWING	MANUF.	MANUFACTURER	TOM	TOP OF MASONRY
EA	EACH	MC	MECHANICAL CONTRACTOR	TOP	TOP OF PLATE
EC	ELECTRICAL CONTRACTOR	MH.	MANHOLE	TOS	TOP OF SLAB
EF	EXHAUST FAN	MECH.	MECHANICAL	TOW	TOP OF WALL
ELEC.	ELECTRICAL	MIN.	MINIMUM	TYP.	TYPICAL
ENCL.	ENCLOSURE	MO.	MASONRY OPENING	TS	TOP OF STEEL
EOS	EDGE OF SLAB	MTD.	MOUNTED	TS	TUBE STEEL
EQ.C.	EQUIPMENT CONTRACTOR	MTL.	METAL	VERT.	VERTICAL
EWC	ELECTRIC WATER COOLER	NIC	NOT IN CONTRACT	VIF	VERIFY IN FIELD
EXIST.	EXISTING			WD.	WOOD

UNCW
THE UNIVERSITY OF NORTH CAROLINA AT WILMINGTON

Revisions

No.	Date

Project Number 0732.DOBO
Date Feb 08
Drawn TJC
Checked JLW
Scale As Noted
Drawing Title
Title Sheet and Index of drawings

Sheet Number 1 of 10
Drawing Number G-101