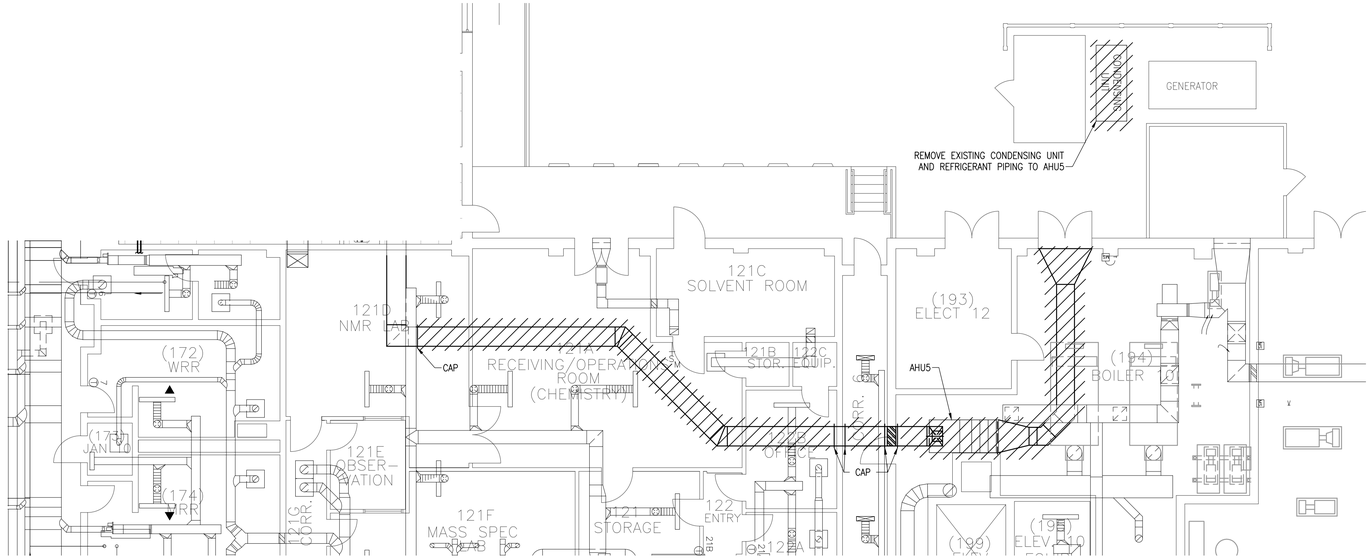

NORTH

1 -First Floor Mechanical Demolition Plan

1/8"=1'-0"

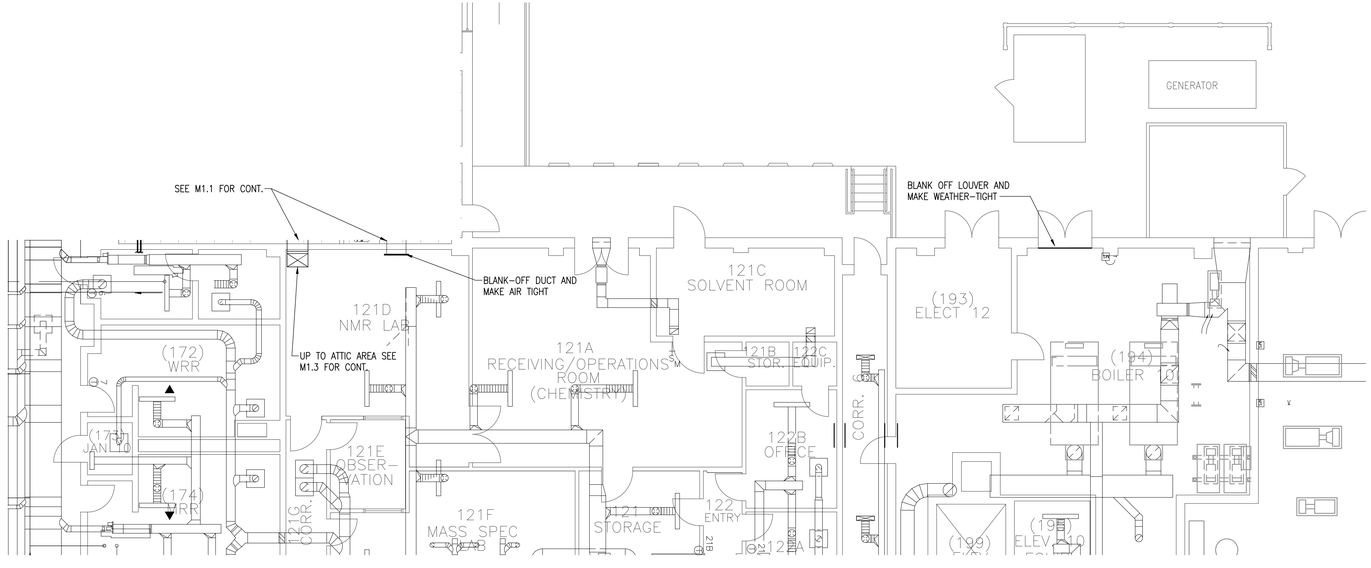

NORTH

2 -First Floor Mechanical New Work Plan

1/8"=1'-0"

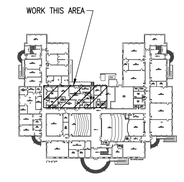

Key Plan

Not To Scale

8' 6' 4' 2' 0 4' 8' 12' 16'

SCALE:1/8" = 1'-0"

Revision No.	Description	Date
1	ISSUED FOR RECORD DRAWING	05.04.15
0	ISSUED FOR REVIEW	09.30.14

REVISIONS

CBHF Engineers, PLLC
3808 Park Avenue
Wilmington, NC 28403
Phone: 910.791.4000
Fax: 910.791.5266
www.cbhfengineers.com
NC# P-0506

© Copyright 2013 CBHF Engineers, PLLC

THIS DOCUMENT ORIGINALLY ISSUED AND SEALED BY: JOHN H. McNALLY PE, NC 8737 ON 09/30/14 THIS MEDIA SHALL NOT BE CONSIDERED A CERTIFIED DOCUMENT.

UNC- Wilmington Dobo Hall Suite 120
601 S. College Road
Wilmington, NC

Mechanical
First Floor Demolition & HVAC Plans

Job No.:	14147
Drawn:	RWC
Designed:	RWC
Checked:	JHM

Drawing No:

M1.2

Revision:
1

Drawing: N:\UNCW\14147-Dobo Hall Suite 120\Outlook\2015-06-29 Rec Dwgs-No Revisions Made\DWG\14147 M1.dwg Plot Time: 6/26/2015 11:20 AM